


J. ANGUS WILSON

2" Gas LINE

W. S. POSTLEWAITE

W. E. MENEELY

D. D. BORTZ
 COUNTRY MINE
 PERRY TWP., JEFFERSON CO., PA.
 SCALE 1"=100' MARCH-1935
 HARRY M. WALKER
 ENGINEER
 PUNXSUTAWNEY, PA.

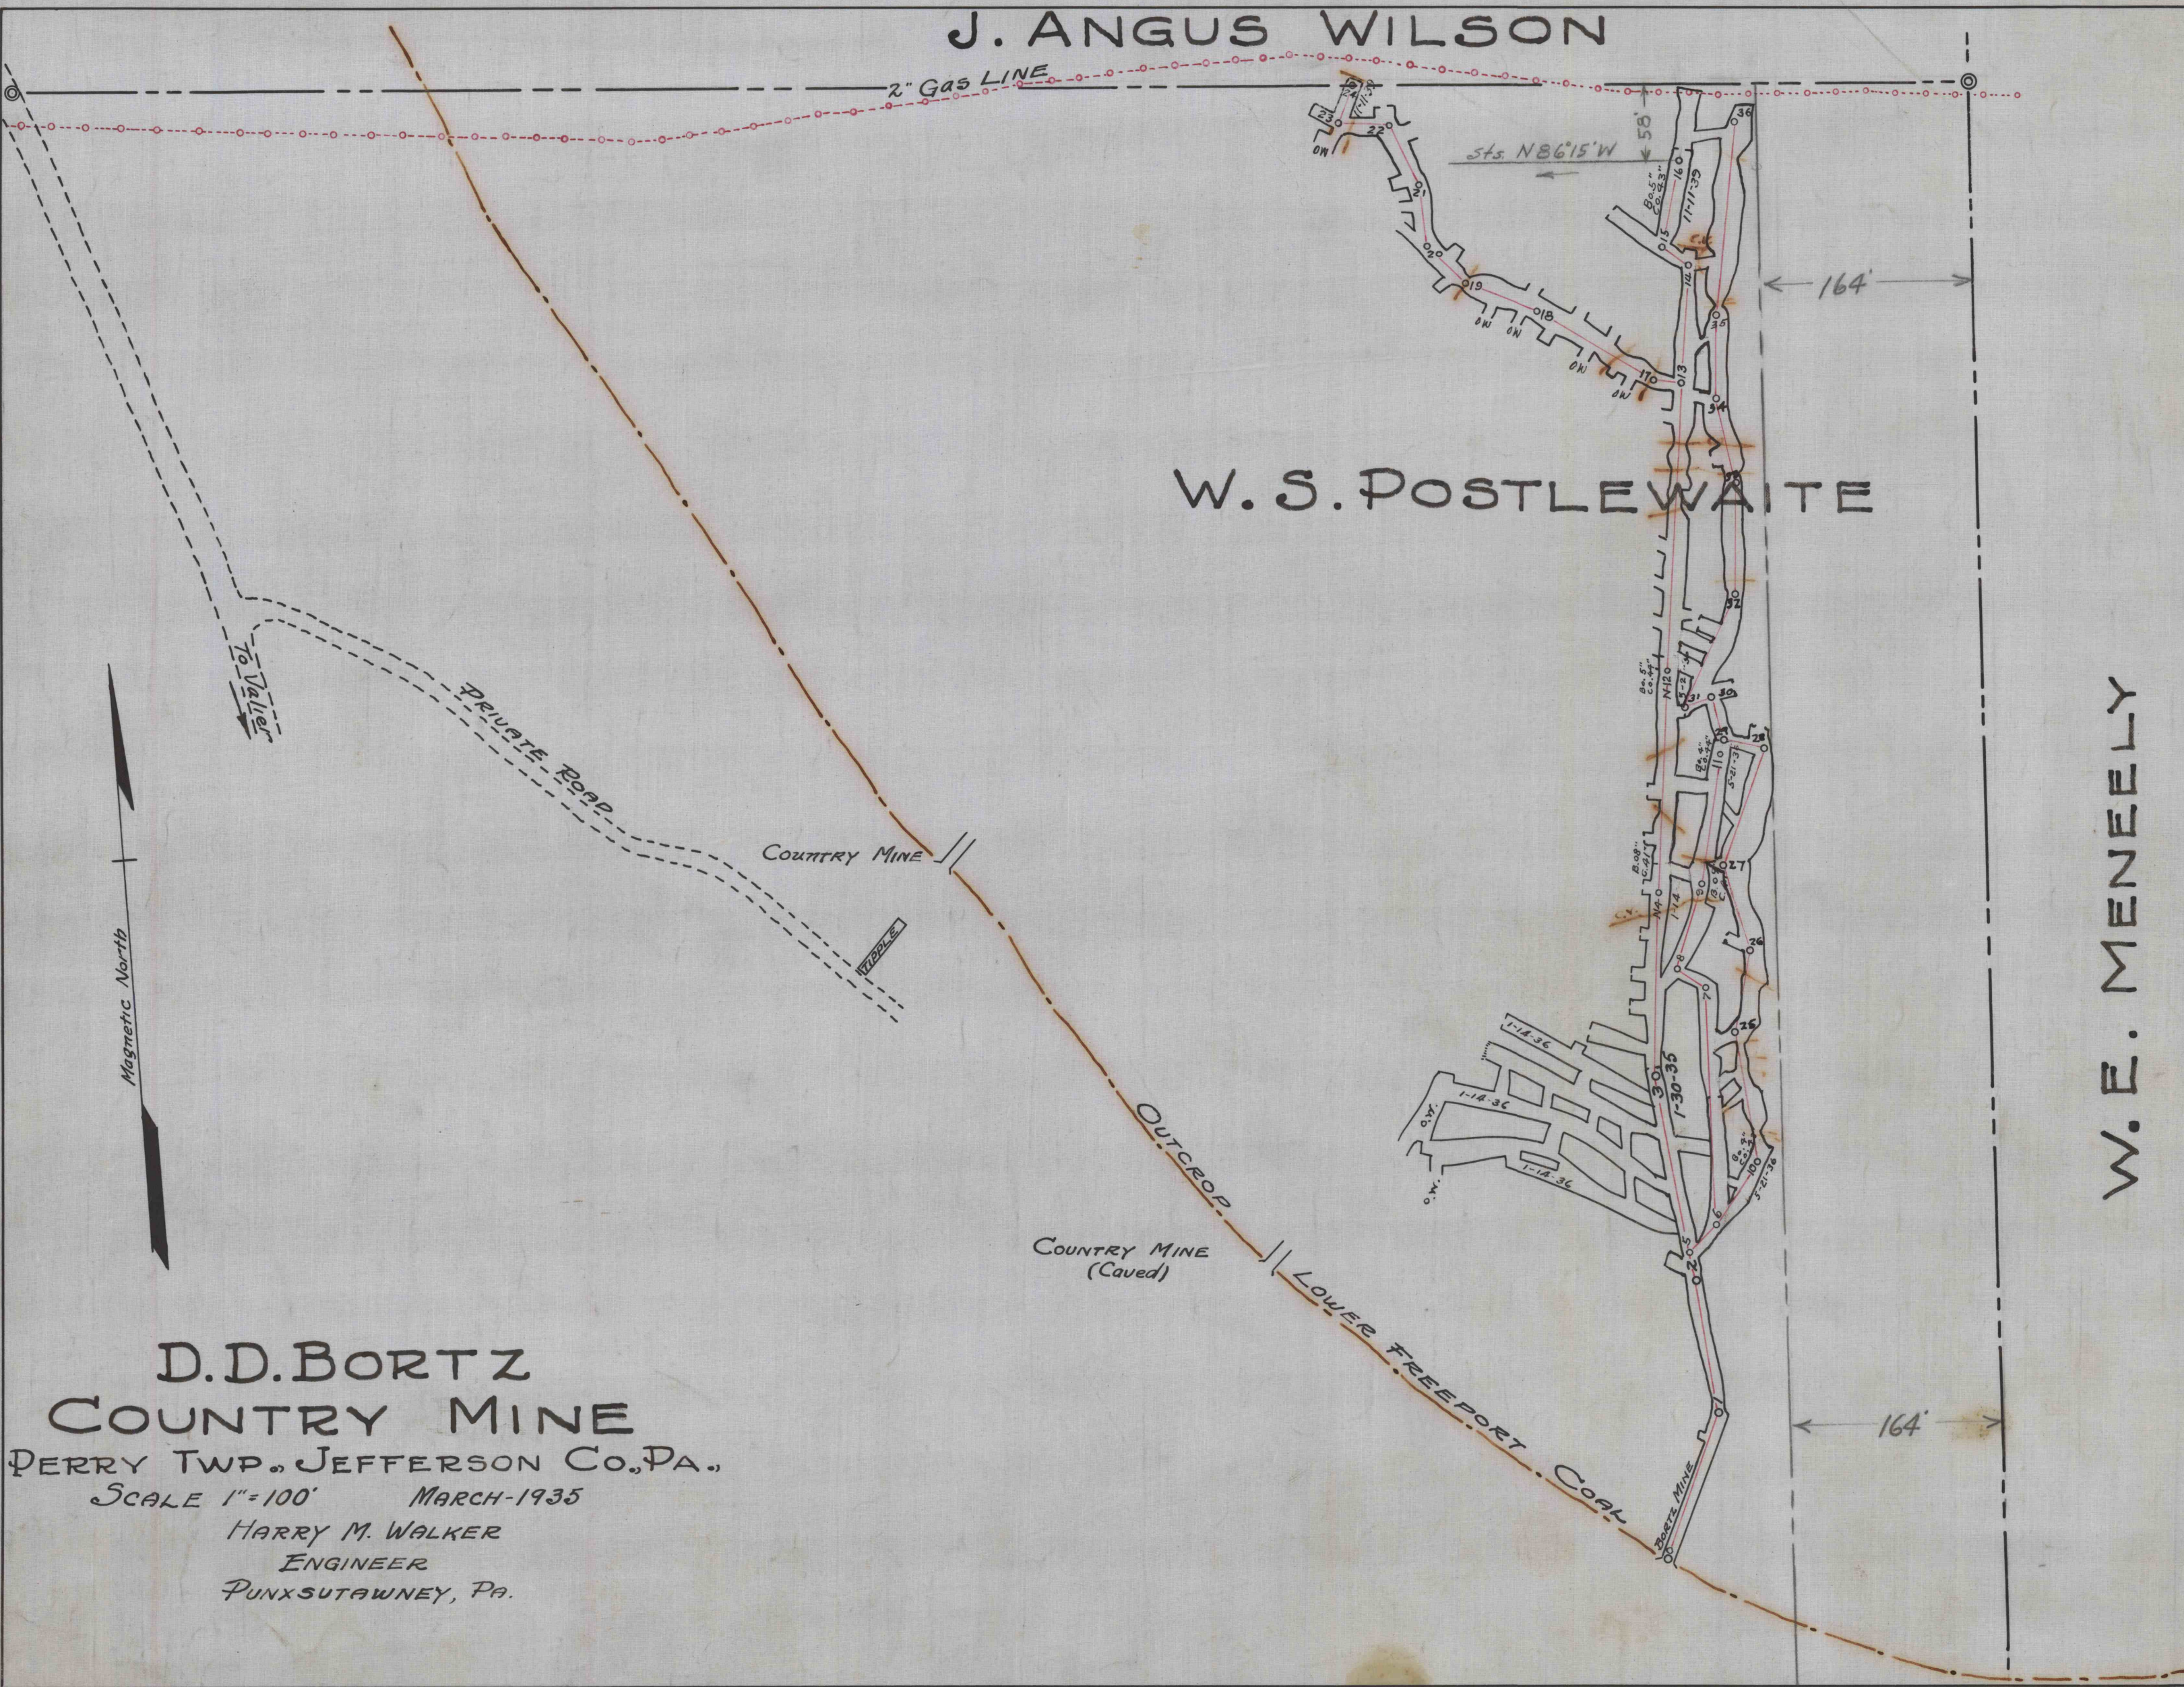

To Valley

PRIVATE ROAD

COUNTRY MINE

WIDENING

OUTCROP

COUNTRY MINE (Caved)

LOWER FREEPORT COAL

BORTZ MINE

Sts. N86°15'W

164'

164'

58'

80.5'

80.5'

D.D. BORTZ
 COUNTRY MINE
 PERRY TWP., JEFFERSON CO., PA.
 SCALE 1"=100' MARCH-1935
 HARRY M. WALKER
 ENGINEER
 PUNXSUTAWNEY, PA.