


801-75C
Hand-drawn map of mine workings

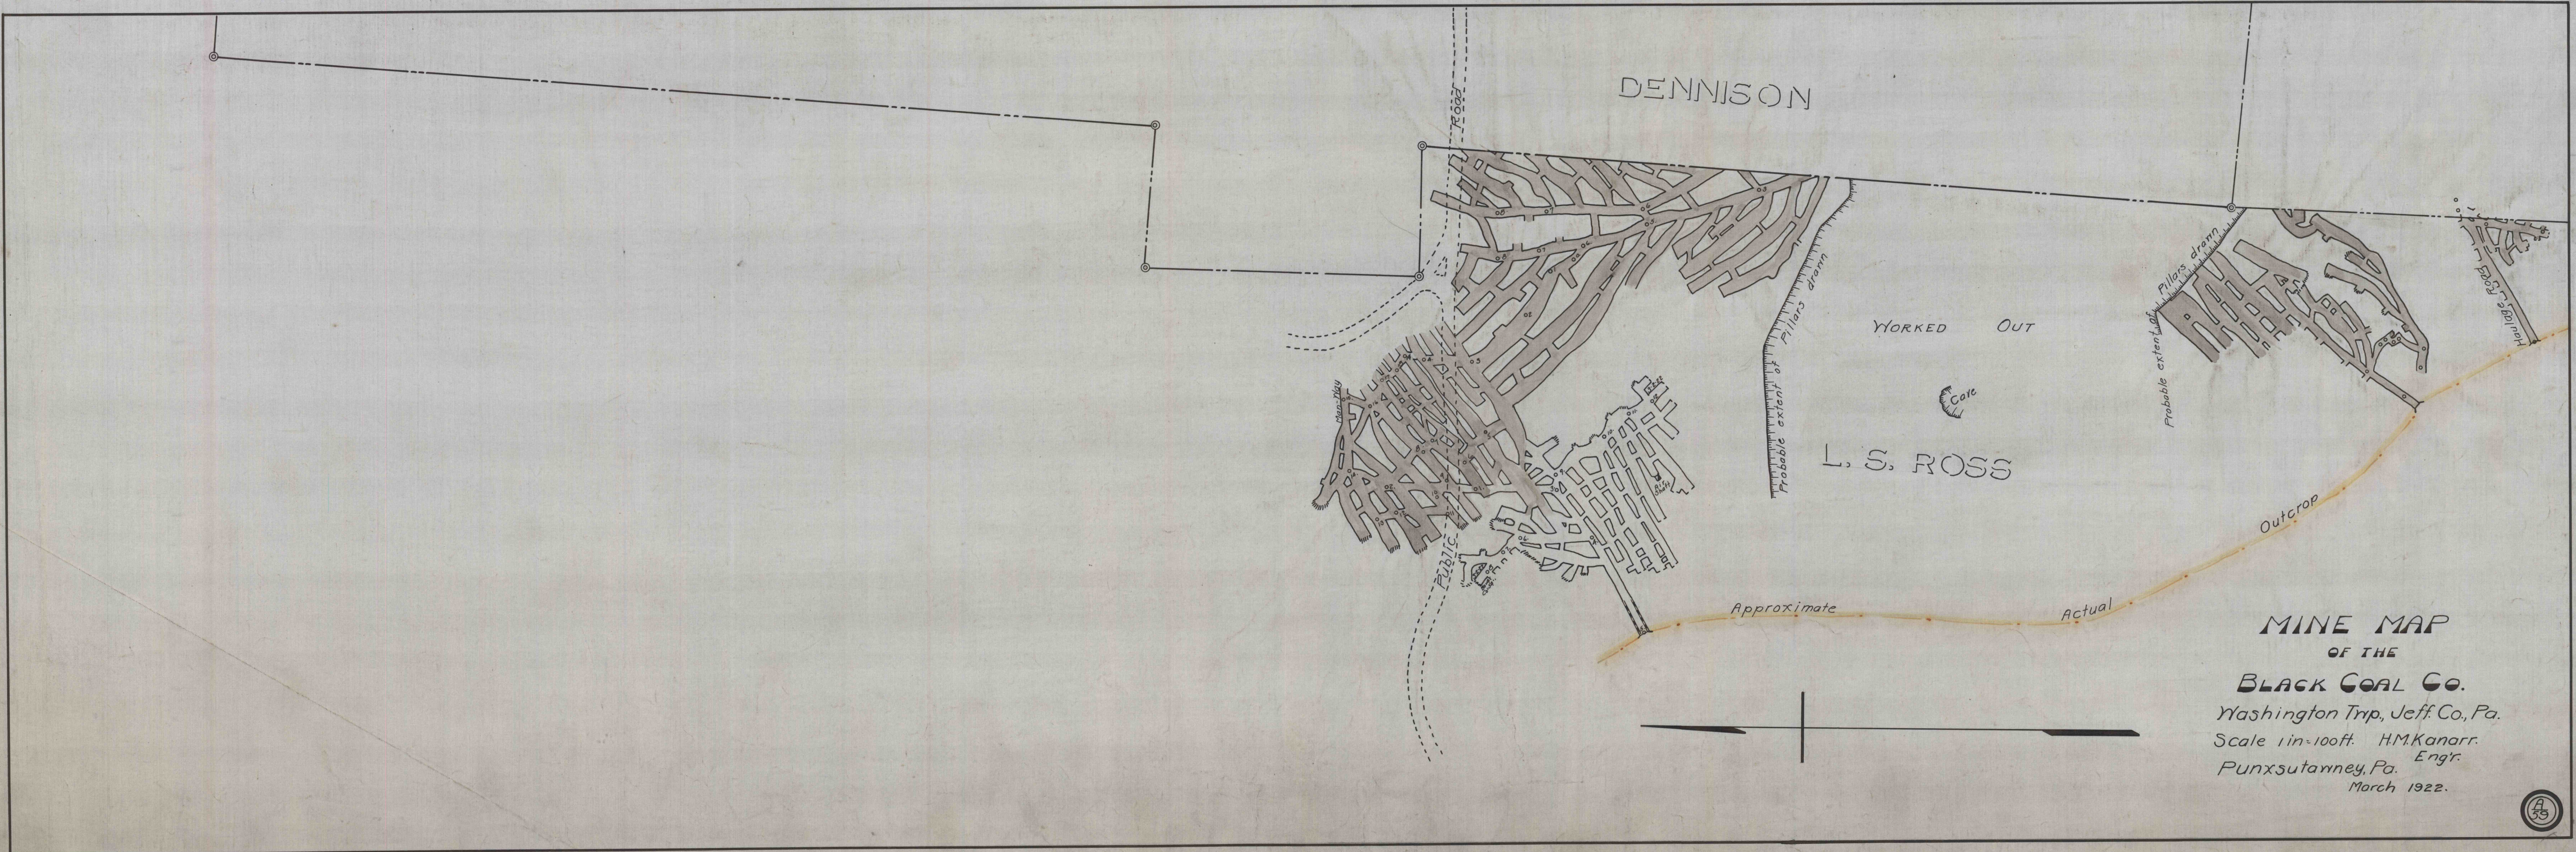

DENNISON

WORKED OUT

L. S. ROSS

Outcrop

Approximate

Actual

MINE MAP

OF THE

BLACK COAL CO.

Washington Twp, Jeff. Co., Pa.

Scale 1 in = 100 ft. H.M. Kanarr.

Punxsutawney, Pa. Engr.

March 1922.

