
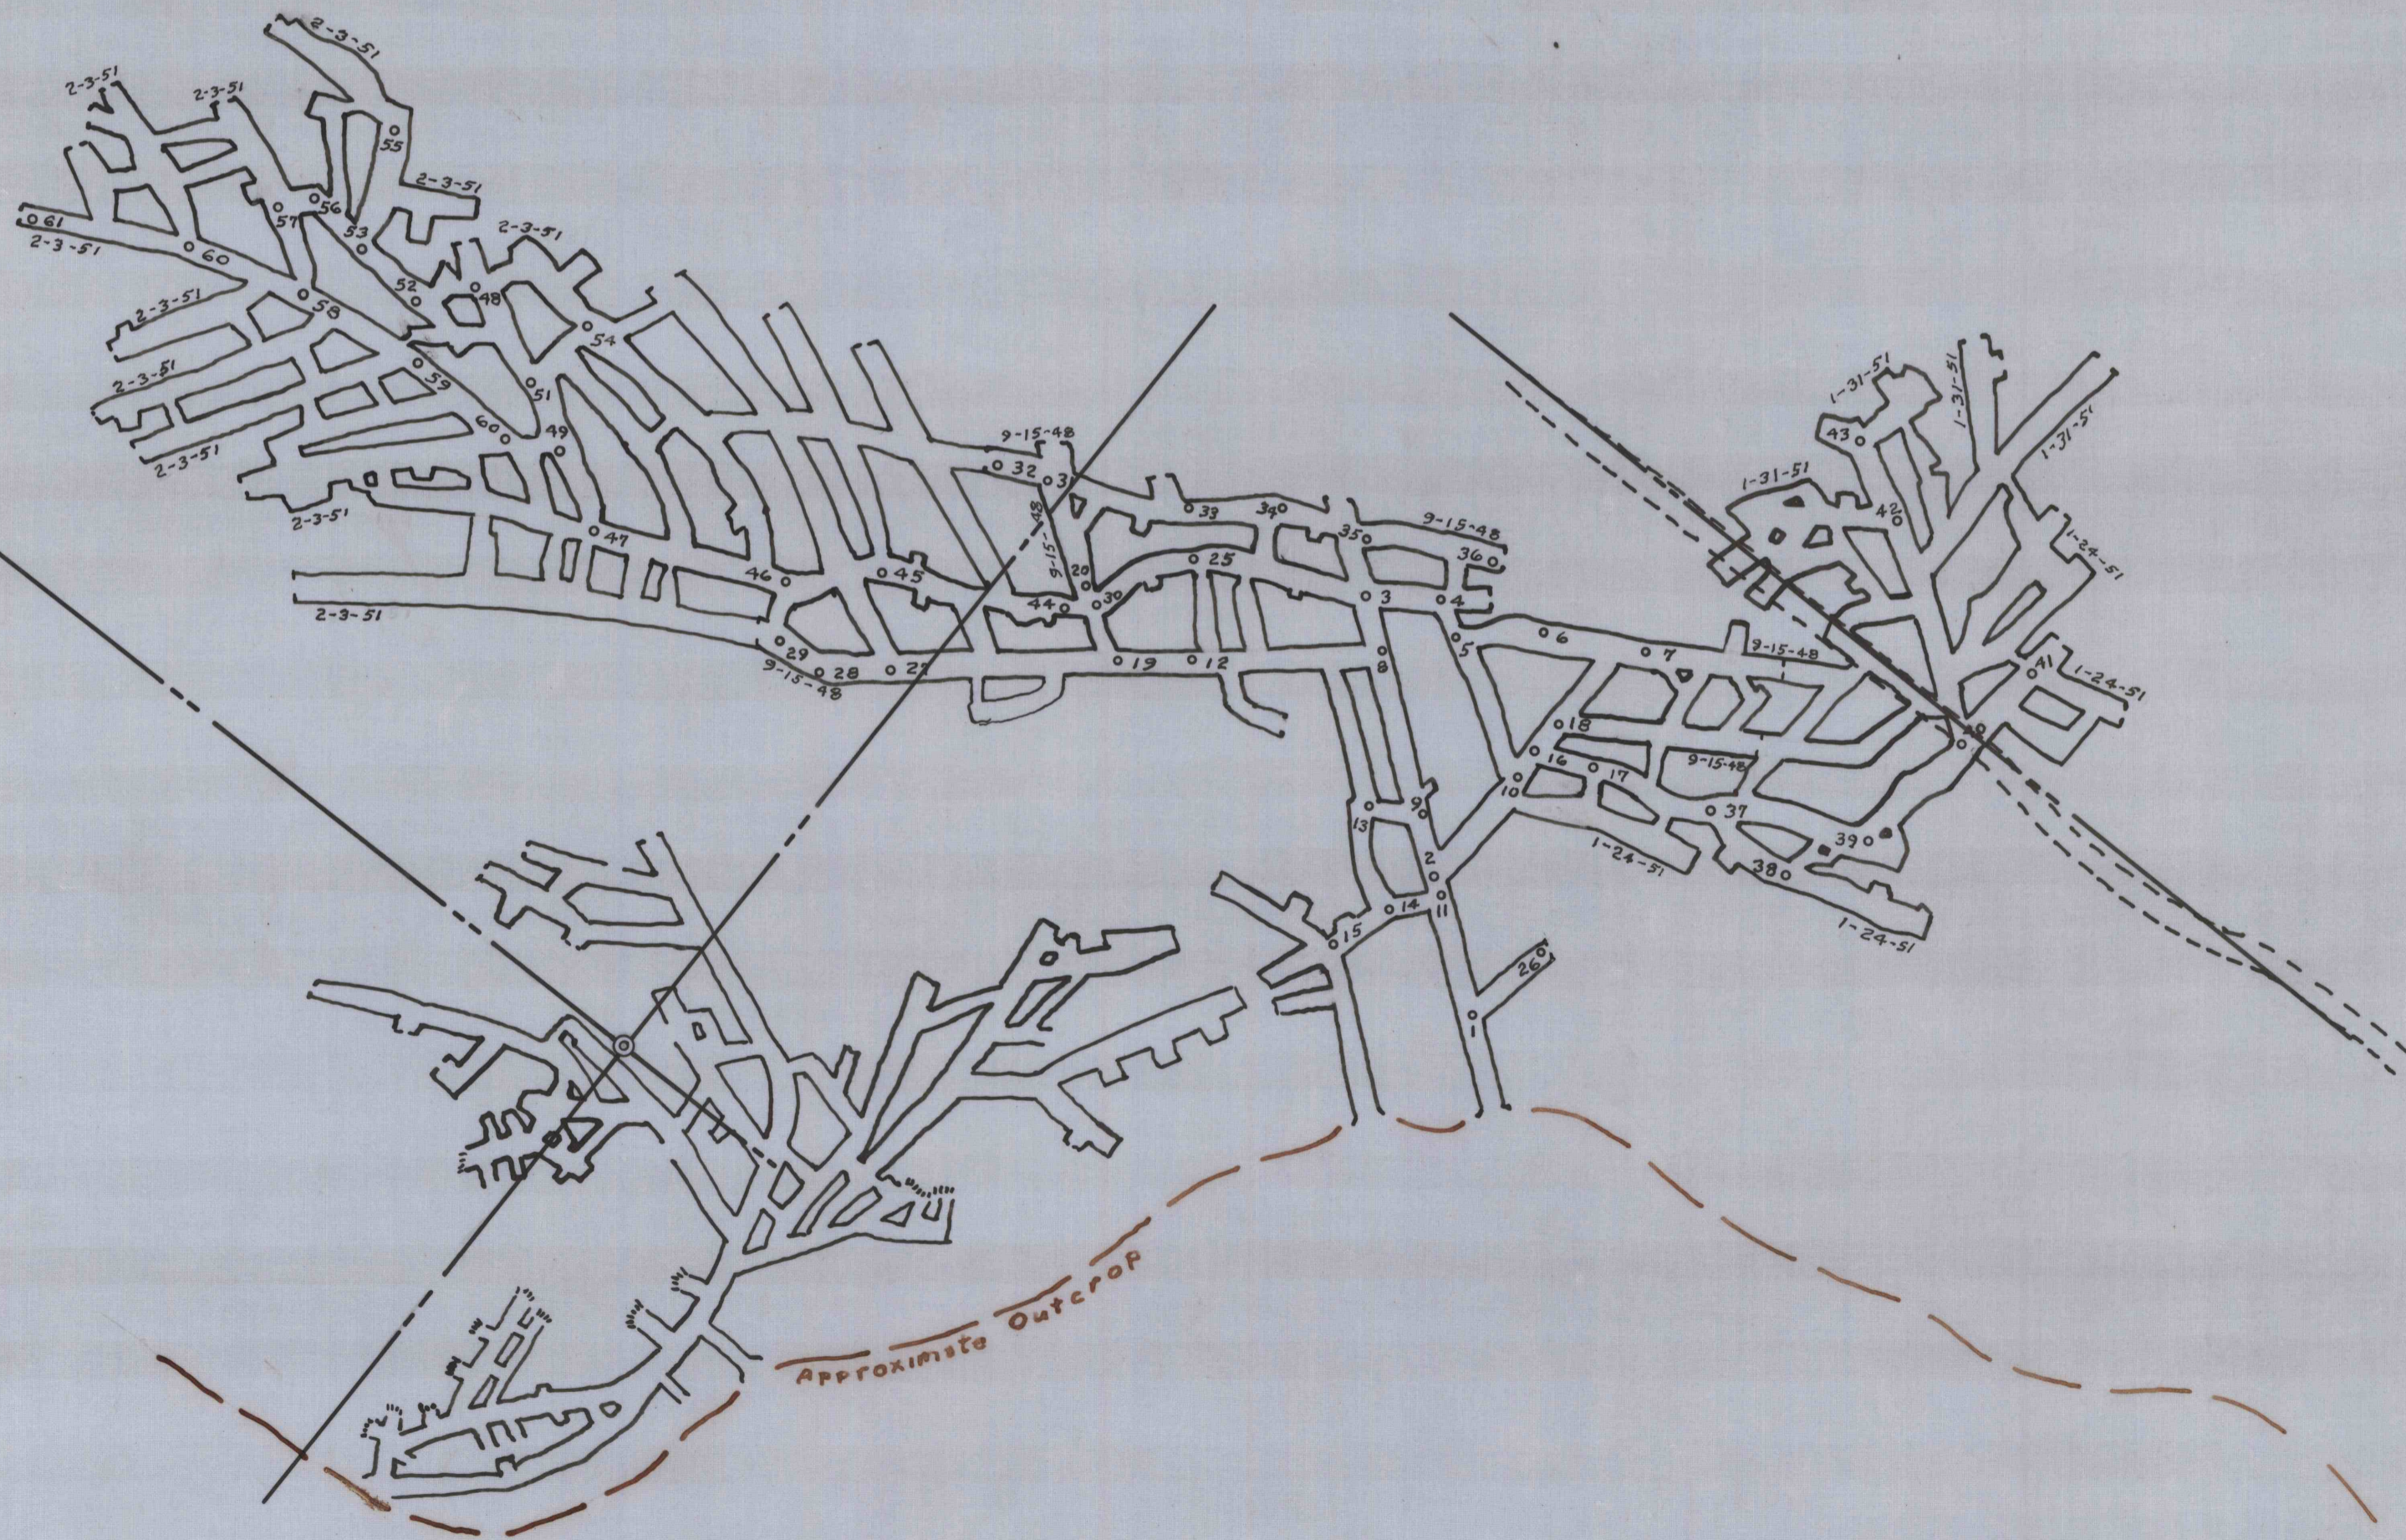


1-B-109

# MINE MAP BARILAR COAL CO. MINE

YOUNG TOWNSHIP, / JEFFERSON COUNTY, PENN'A.  
SCALE 1"=100' JANUARY, 1948  
WALTER J. ZIMMERMAN - SURVEYOR - ENGINEER - PUNXSUTAWNEY, PENN'A.

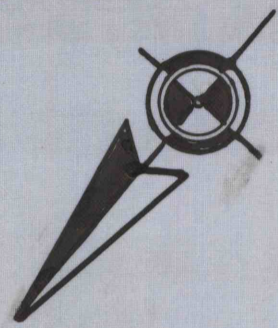

1-B-109

Barilar Coal Co. Mine  
Young Township, Jefferson County, Penna.  
Walter J. Zimmerman, Surveyor-Engineer  
(P1-C-5) (S-D-14)

1-B-109

1-B-109

1-B-109