

328 E 47.69 S
1197'

H. C. WINSLOW

50°15'E 2667'


DDH

DDH

N 0°15' W 2667'

Approx. DDH
B.C. Co.

20000 North

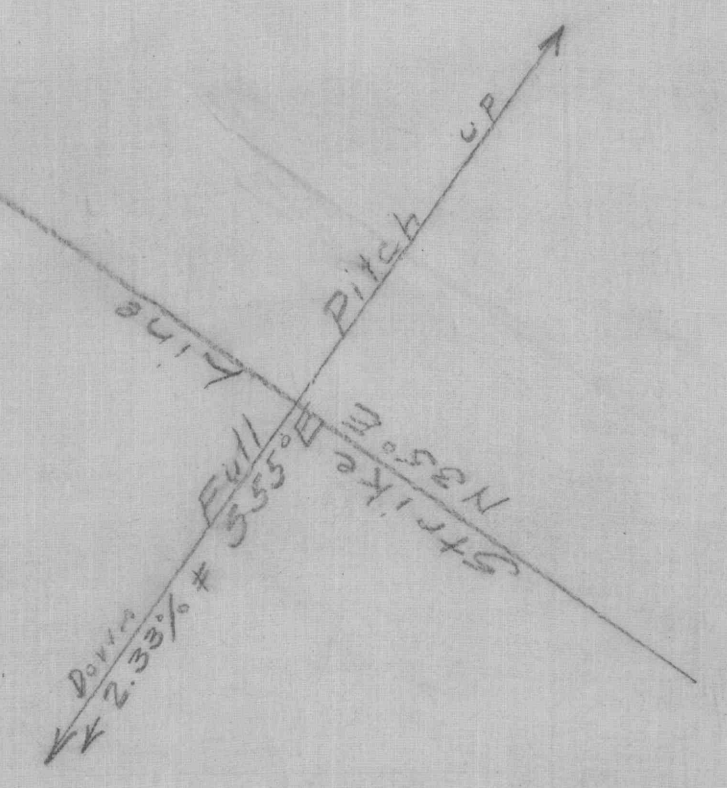

Tram Road

R.R.

3000.0 West

MINE MAP
OF
WINSLOW & WILLIAMS
situate near
WINSLOW, GASKILL TWP.
JEFFERSON CO., PA.
Scale 1"=100' H.M. Kanarr, Eng'r
Feb. 1923. Punxsutawney, Pa.