

COMMONWEALTH OF PENNSYLVANIA
GAME COMMISSION


F.C. DEEMER ESTATE

ROBERT PARK



DATE OF SURVEY

Jan. 15, 1959
June 1, 1960
Dec. 22, 1960
Sept. 28, 1961
Oct. 3, 1962
April 29, 1964

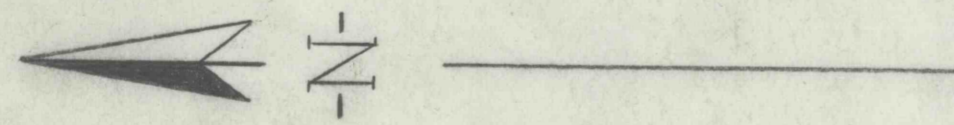

MINE MAP
H.F. SPENCER
COAL MINE

ME Calmont Township, Jefferson County, Pa.

Scale 1"=100' Jan. 15, 1959

Walter J. Zimmerman Engineer Pottsville, Pa.
Fred W. Wise Registered Surveyor P.O. Box 23, Pottsville, Pa.

511-731

111