HENRY CORBIN

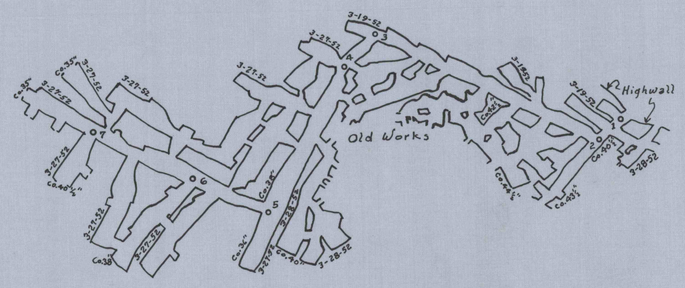

RAYBUCK

W. S. McCLELLAND

MINE MAP OF
PETERSON BROTHERS MINE
ALBERT BRITTON TRACT

WASHINGTON TOWNSHIP, JEFFERSON COUNTY, PA.

Scale 1" = 100' March, 1952

Walter J. Zimmerman, Engineer-Surveyor - Punxsutawney, Pa.

GEORGE RAYBUCK