


I. N. MORRISON.

I. & L. ROSS.


ALTER Mc KAY, SR.

MAP
OF THE
Mc CONNELL MINE
ON THE
DENNISON FARM
WASHINGTON TOWNSHIP
JEFFERSON COUNTY
PENNA.

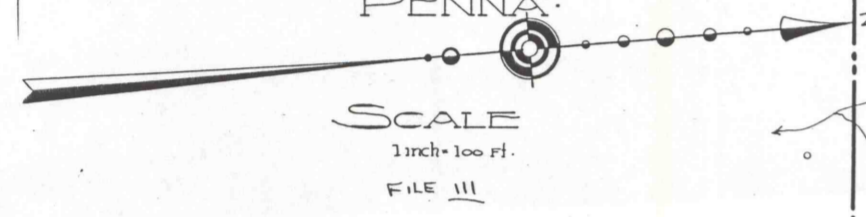

JOE FROST.

- LEGEND
- STRIP MINE BACKFILLED & GRADED
 - SPECIAL CONDITION
 - DISTURBED AREA NOT BACKFILLED
 - ACTIVE STRIP MINE
 - PROPOSED STRIP MINE

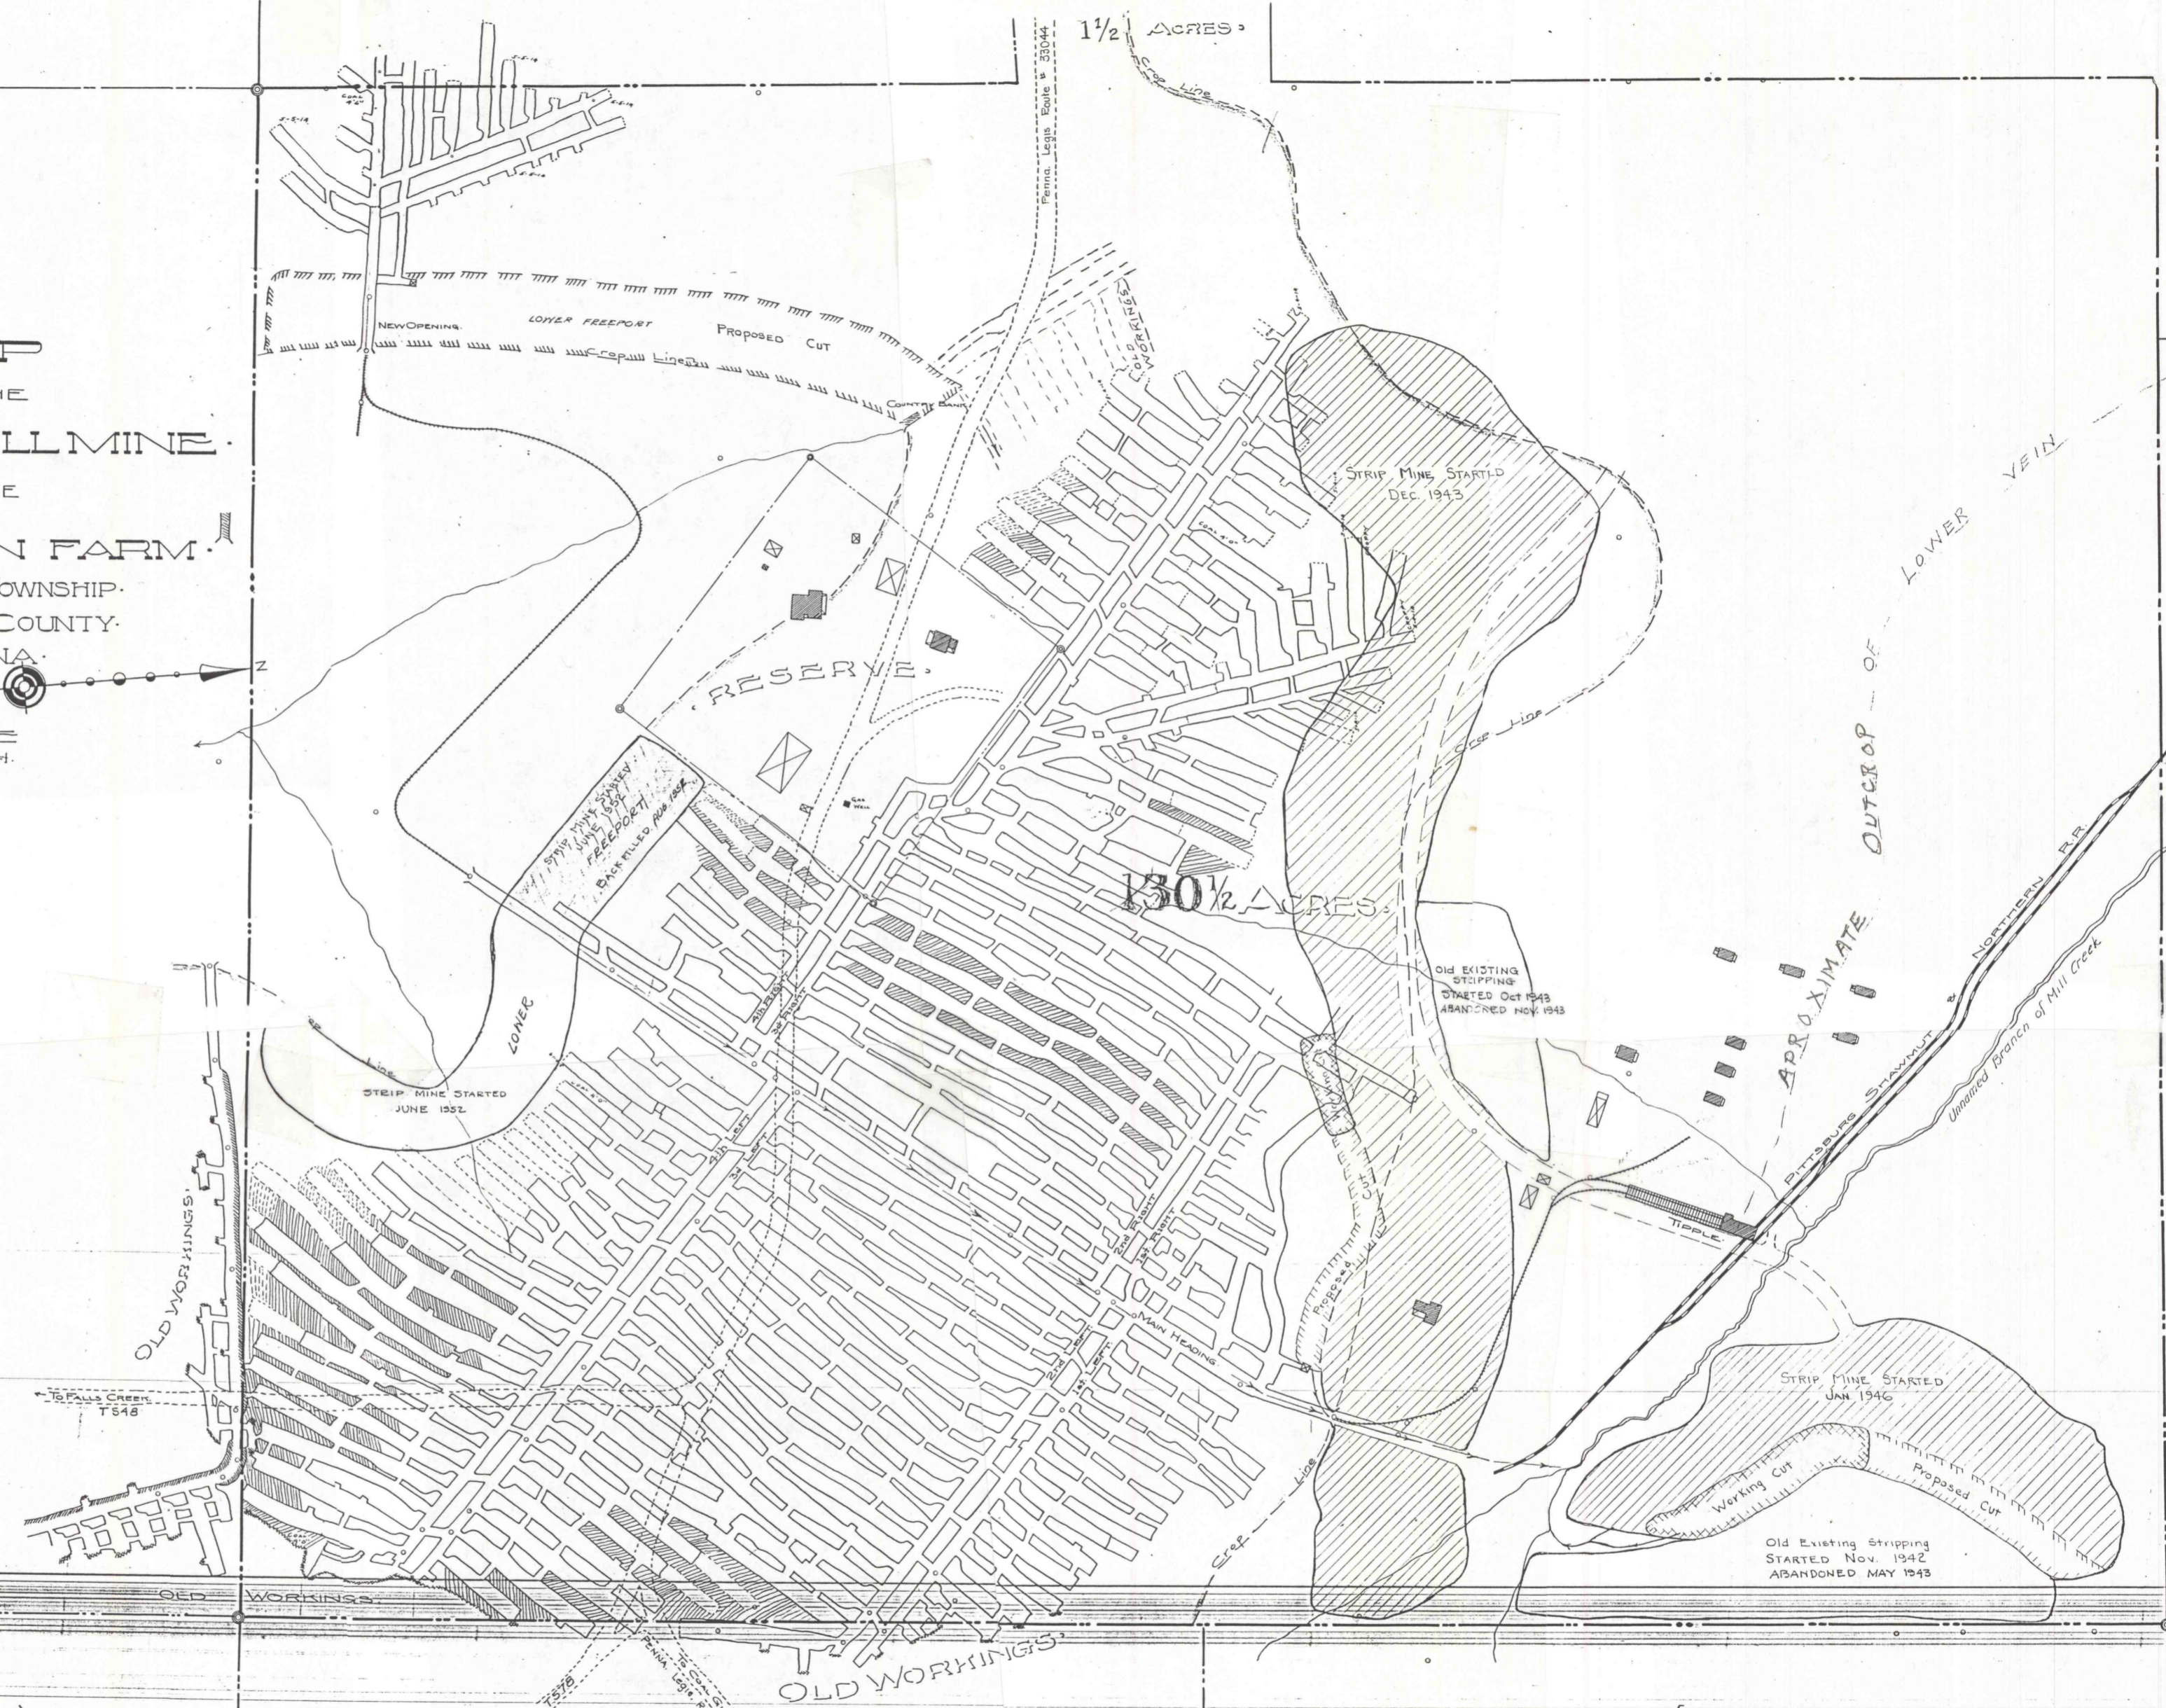

ANDREW ROSS.

MAXWELL.

LARRY VAN NORMAN.

ENGINEERING OFFICE
SIMPSON & MADISON
DUBOIS, PA.

