


JOHN ERNST EST

2000.0 East


JOHN ERNST EST.

SHILTZ

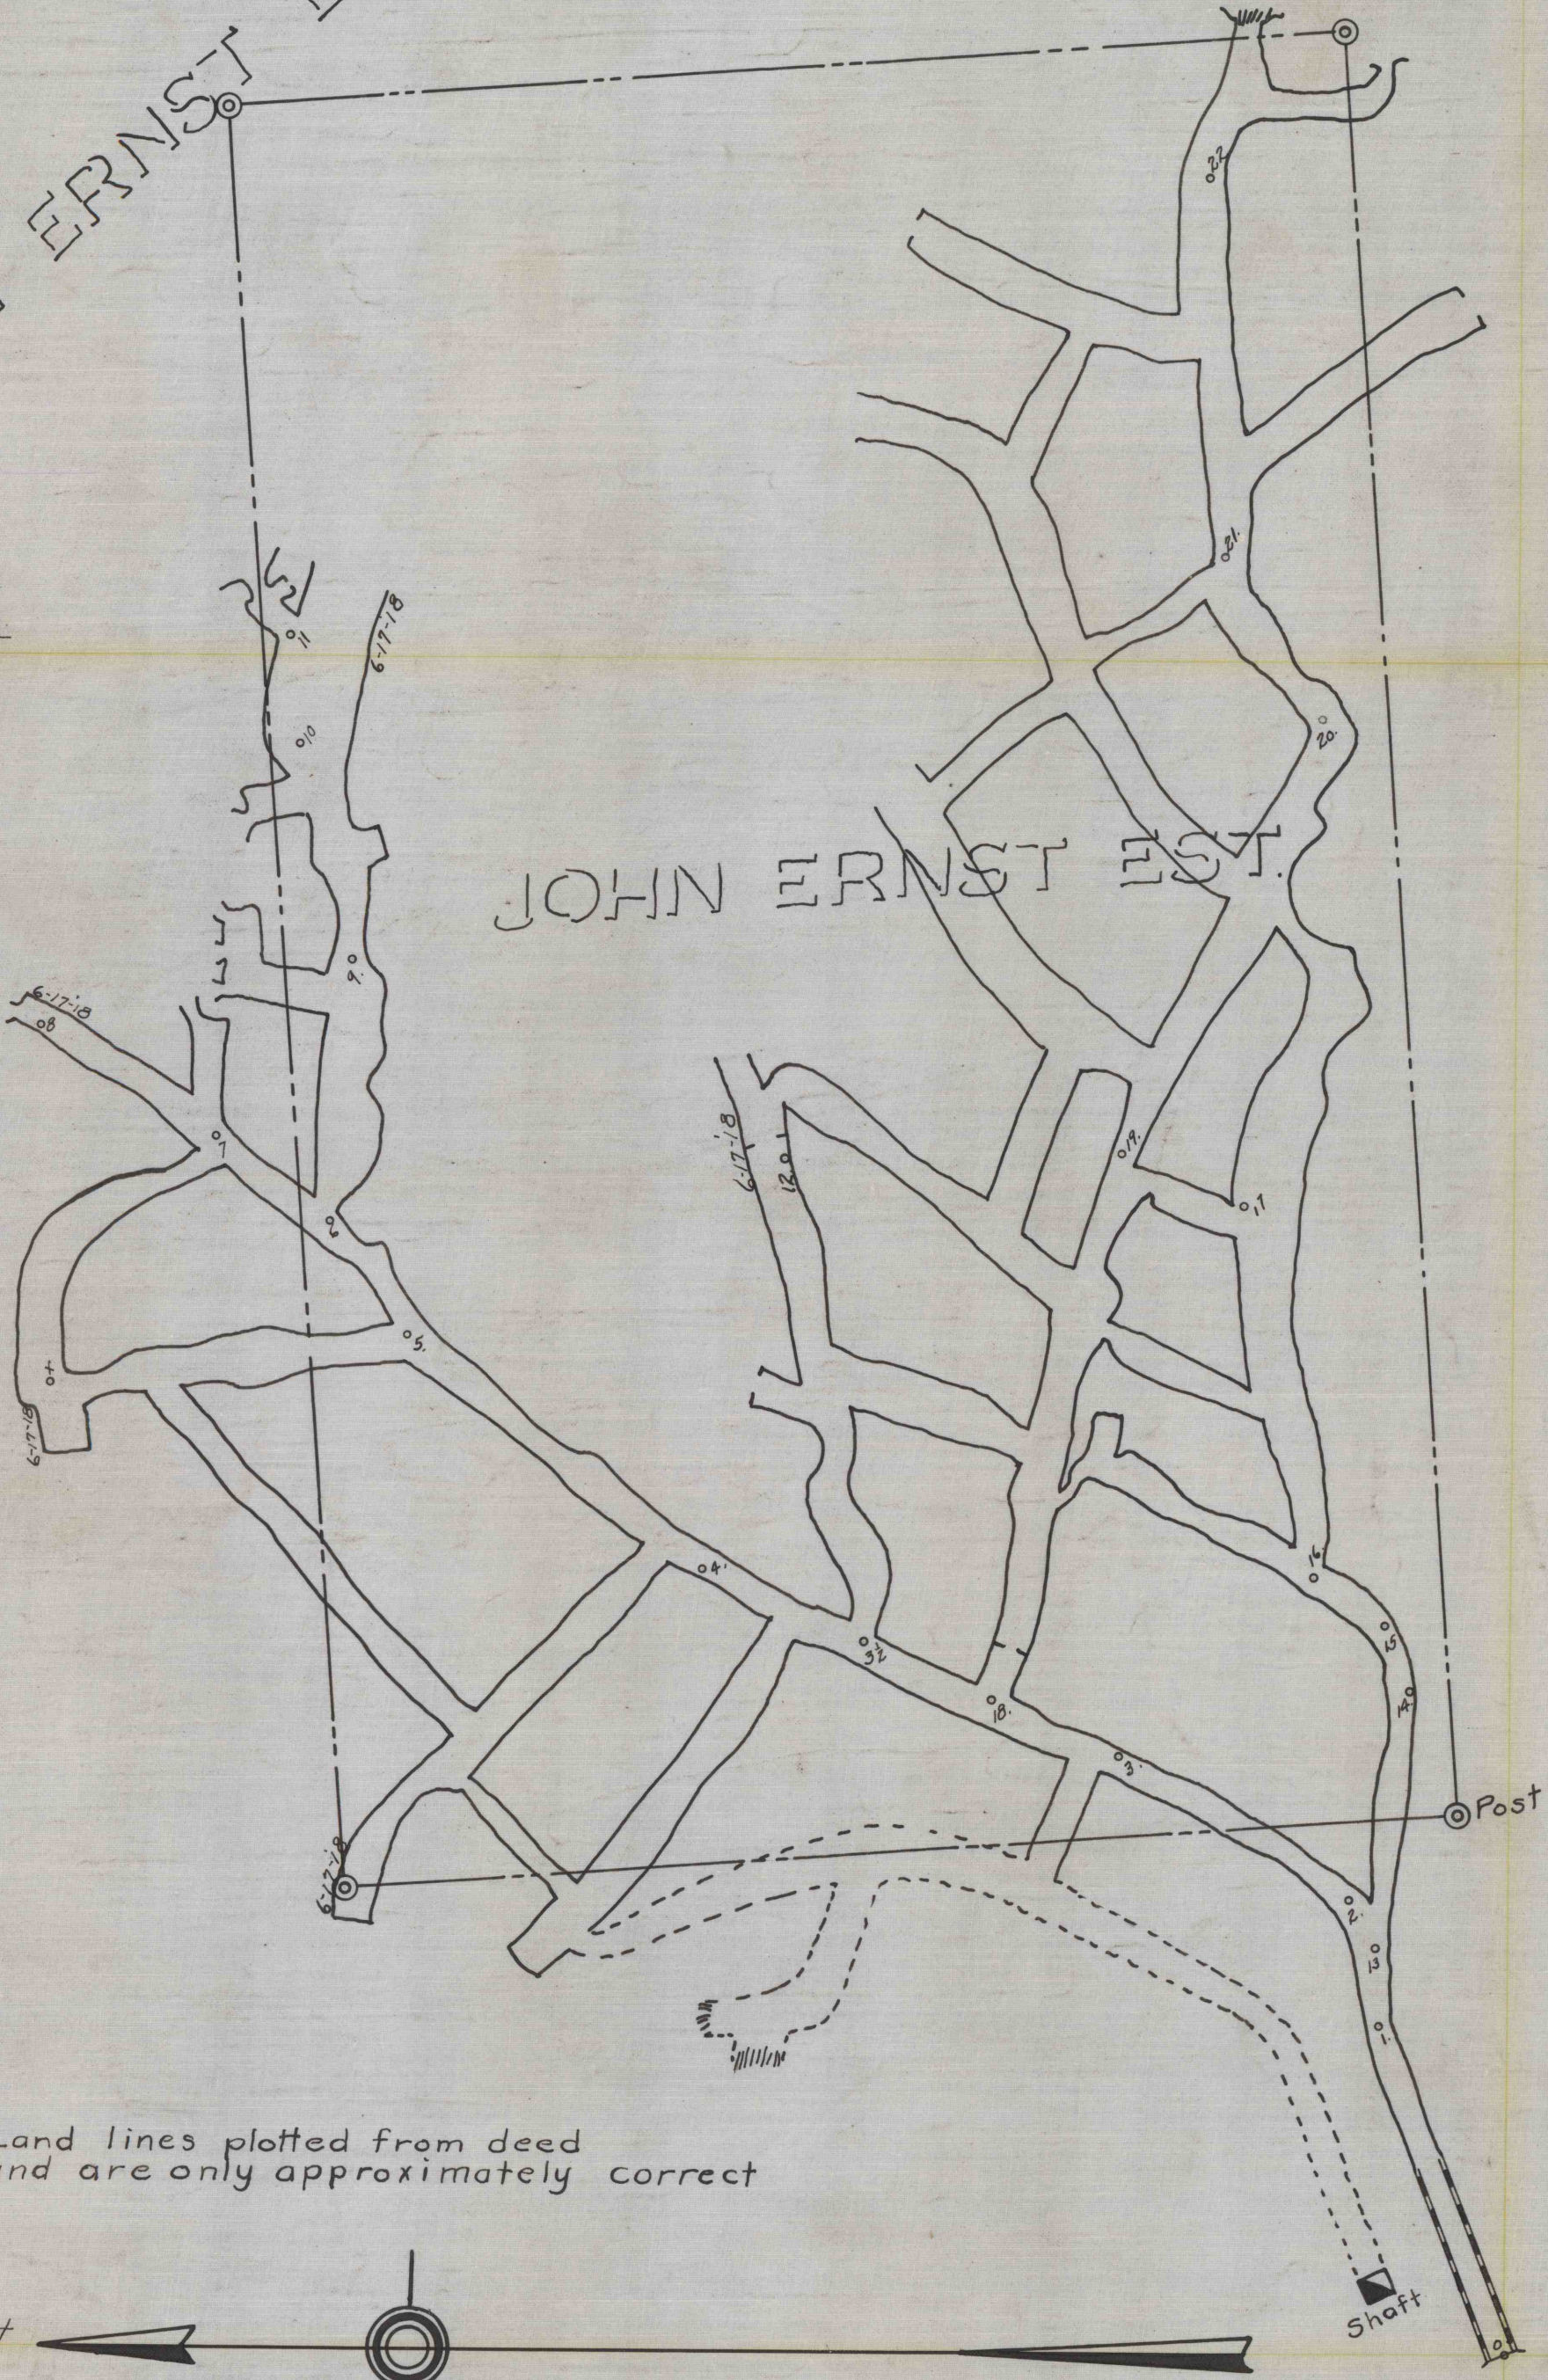

NOTE. Land lines plotted from deed and are only approximately correct

1000.0 East

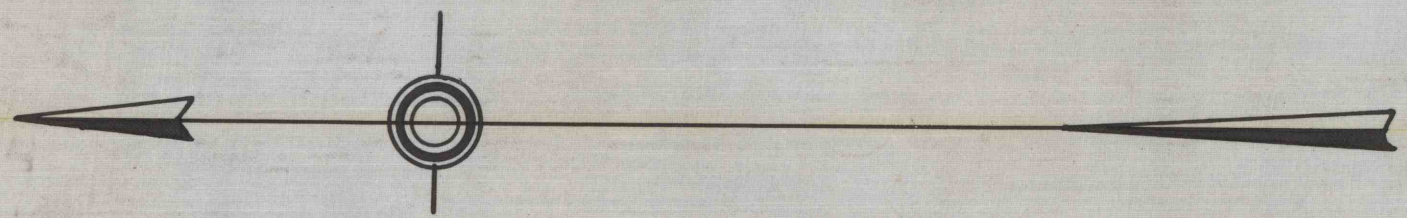

**ZEDIK & KRUCILOCK**  
**Coal Mine near Anita, Jefferson Co., Penna.**

Scale 1"=50'

H.M. Kanarr Eng'r Punxsutawney, Pa.

1000.0 North

