


251-737


0 East

0 North

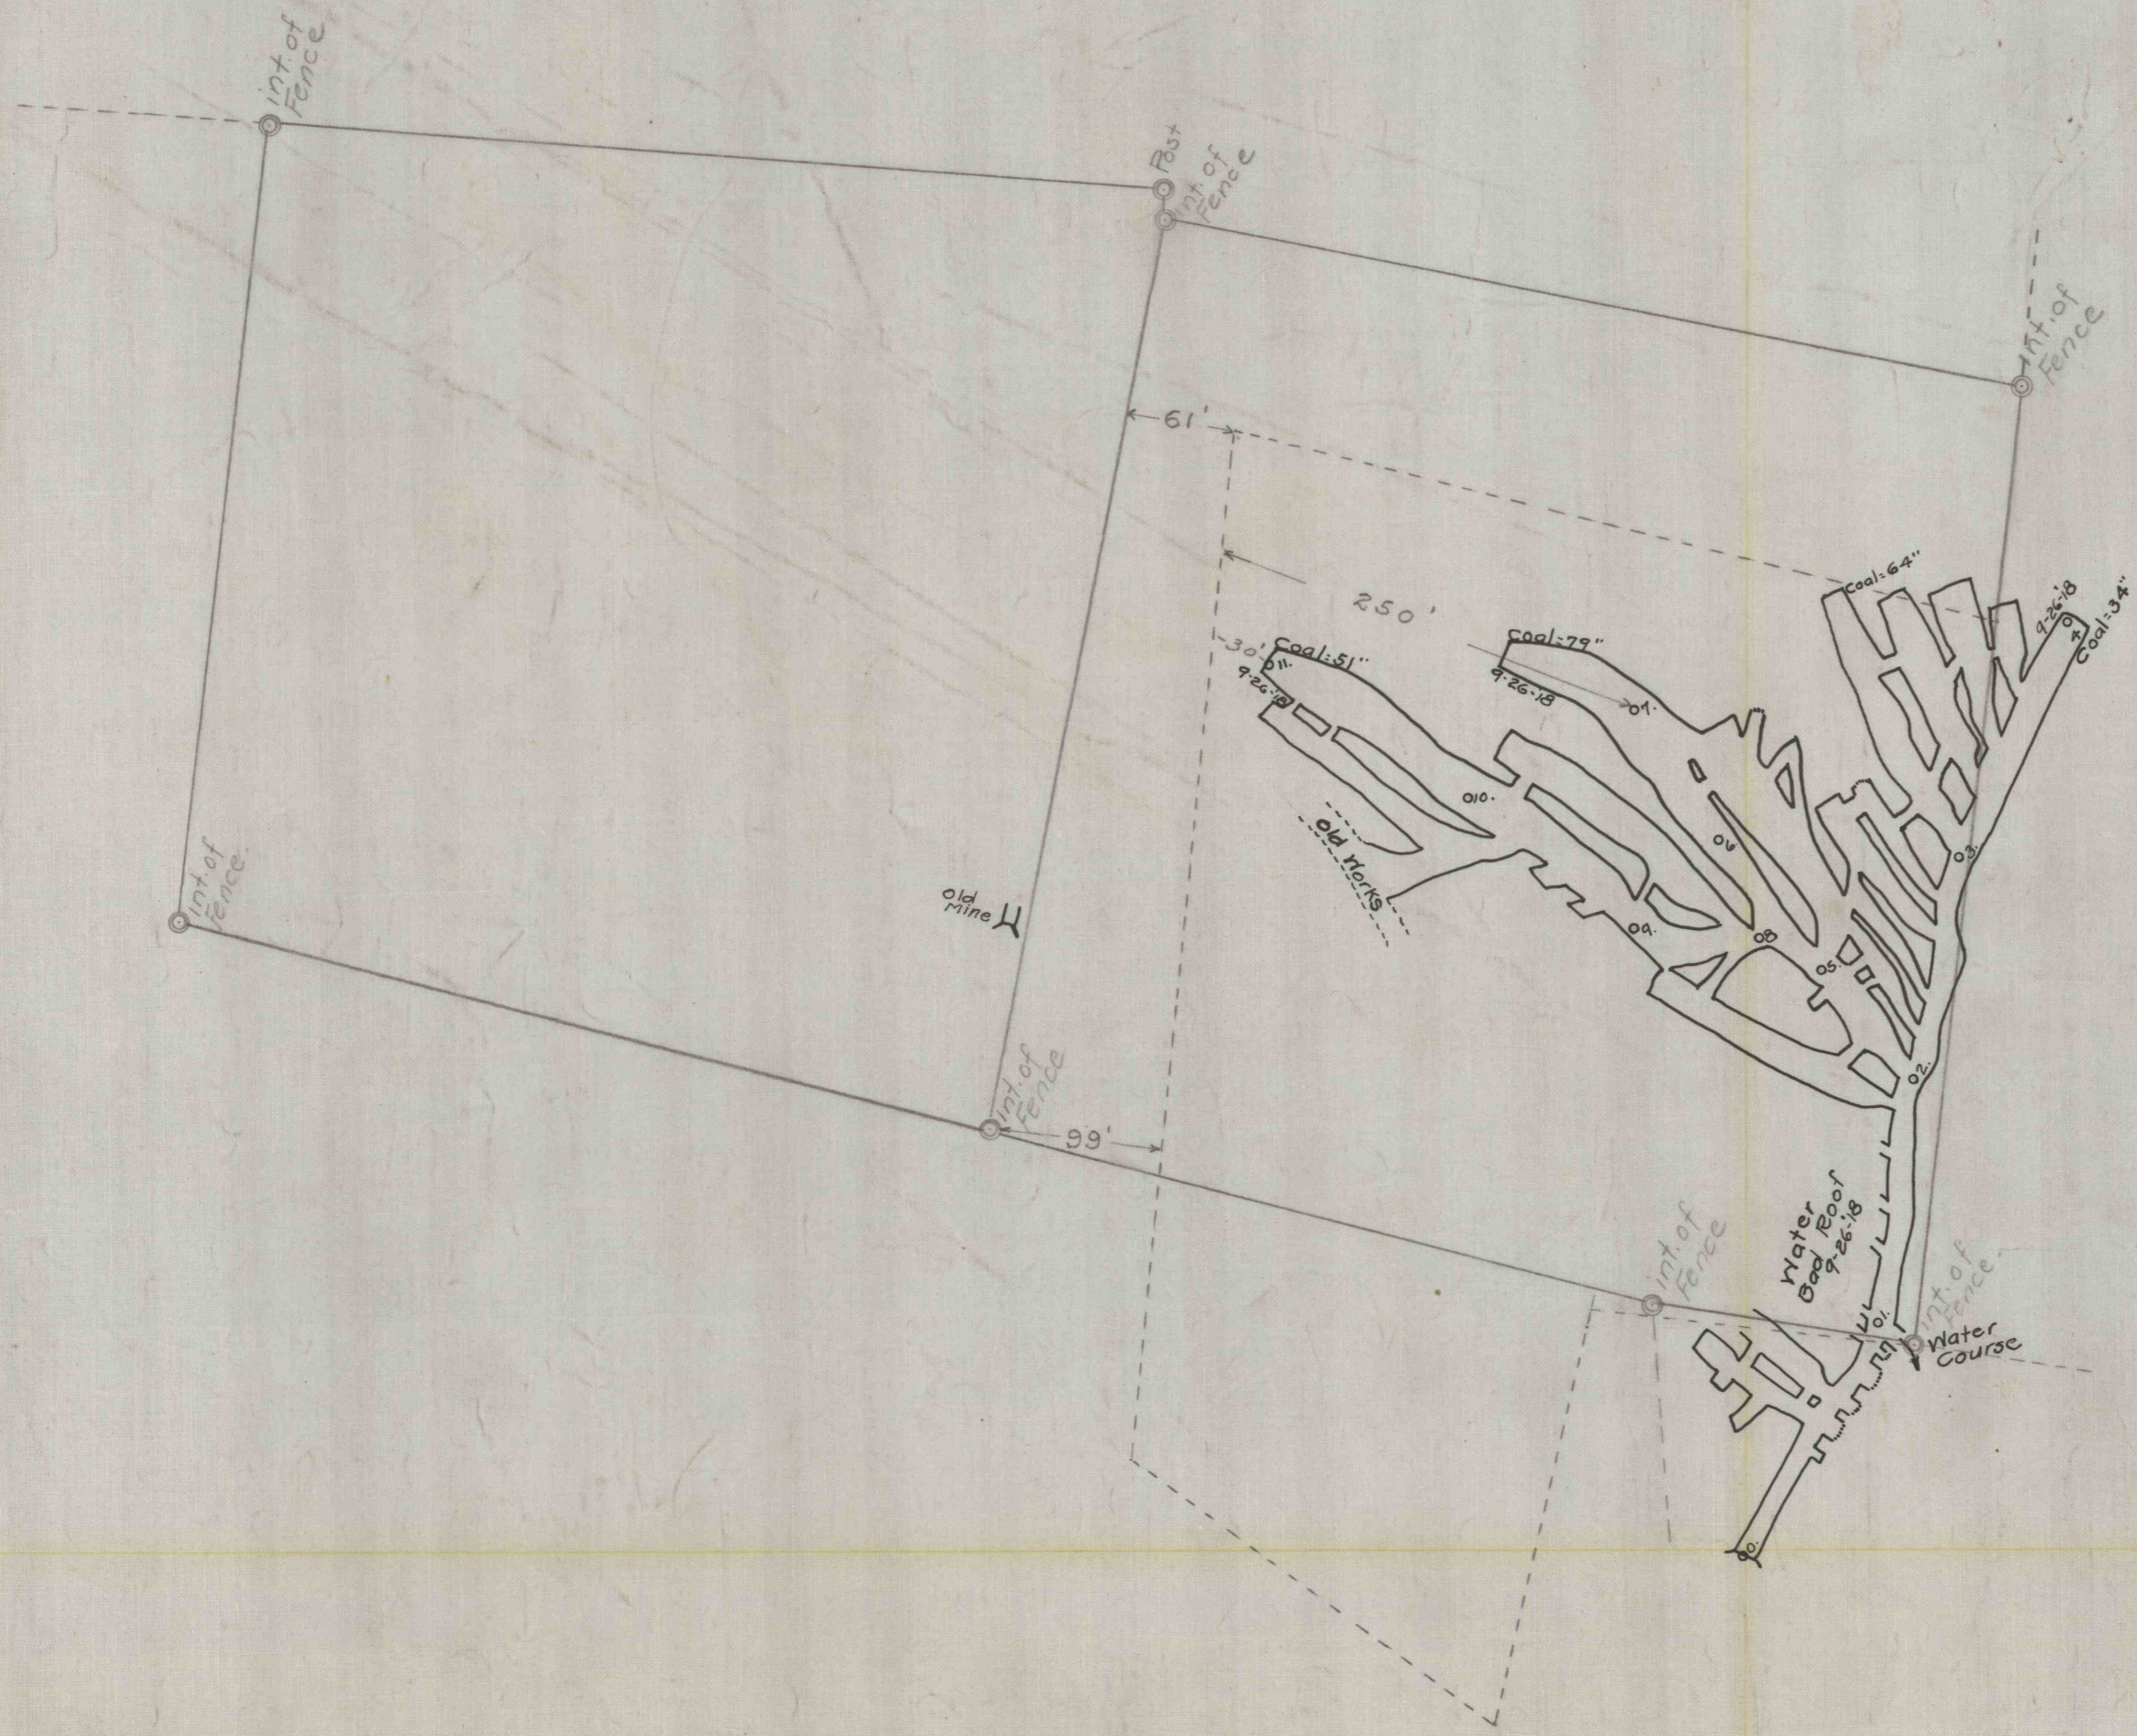

1000.0 East

Map of
 Freas Coal Mine
 Timblin, Penna.
 Scale 1"=100' Oct. 2, 1918
 Punxsutawney Pa H.M. Kanarr Engr.

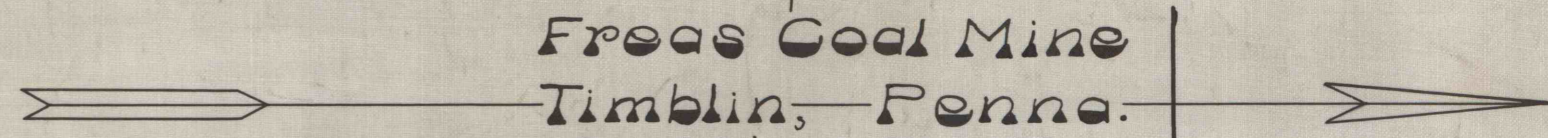

1000.0 North

