


W.C. & J.C.
KENNEDY



H.C. McDivitt

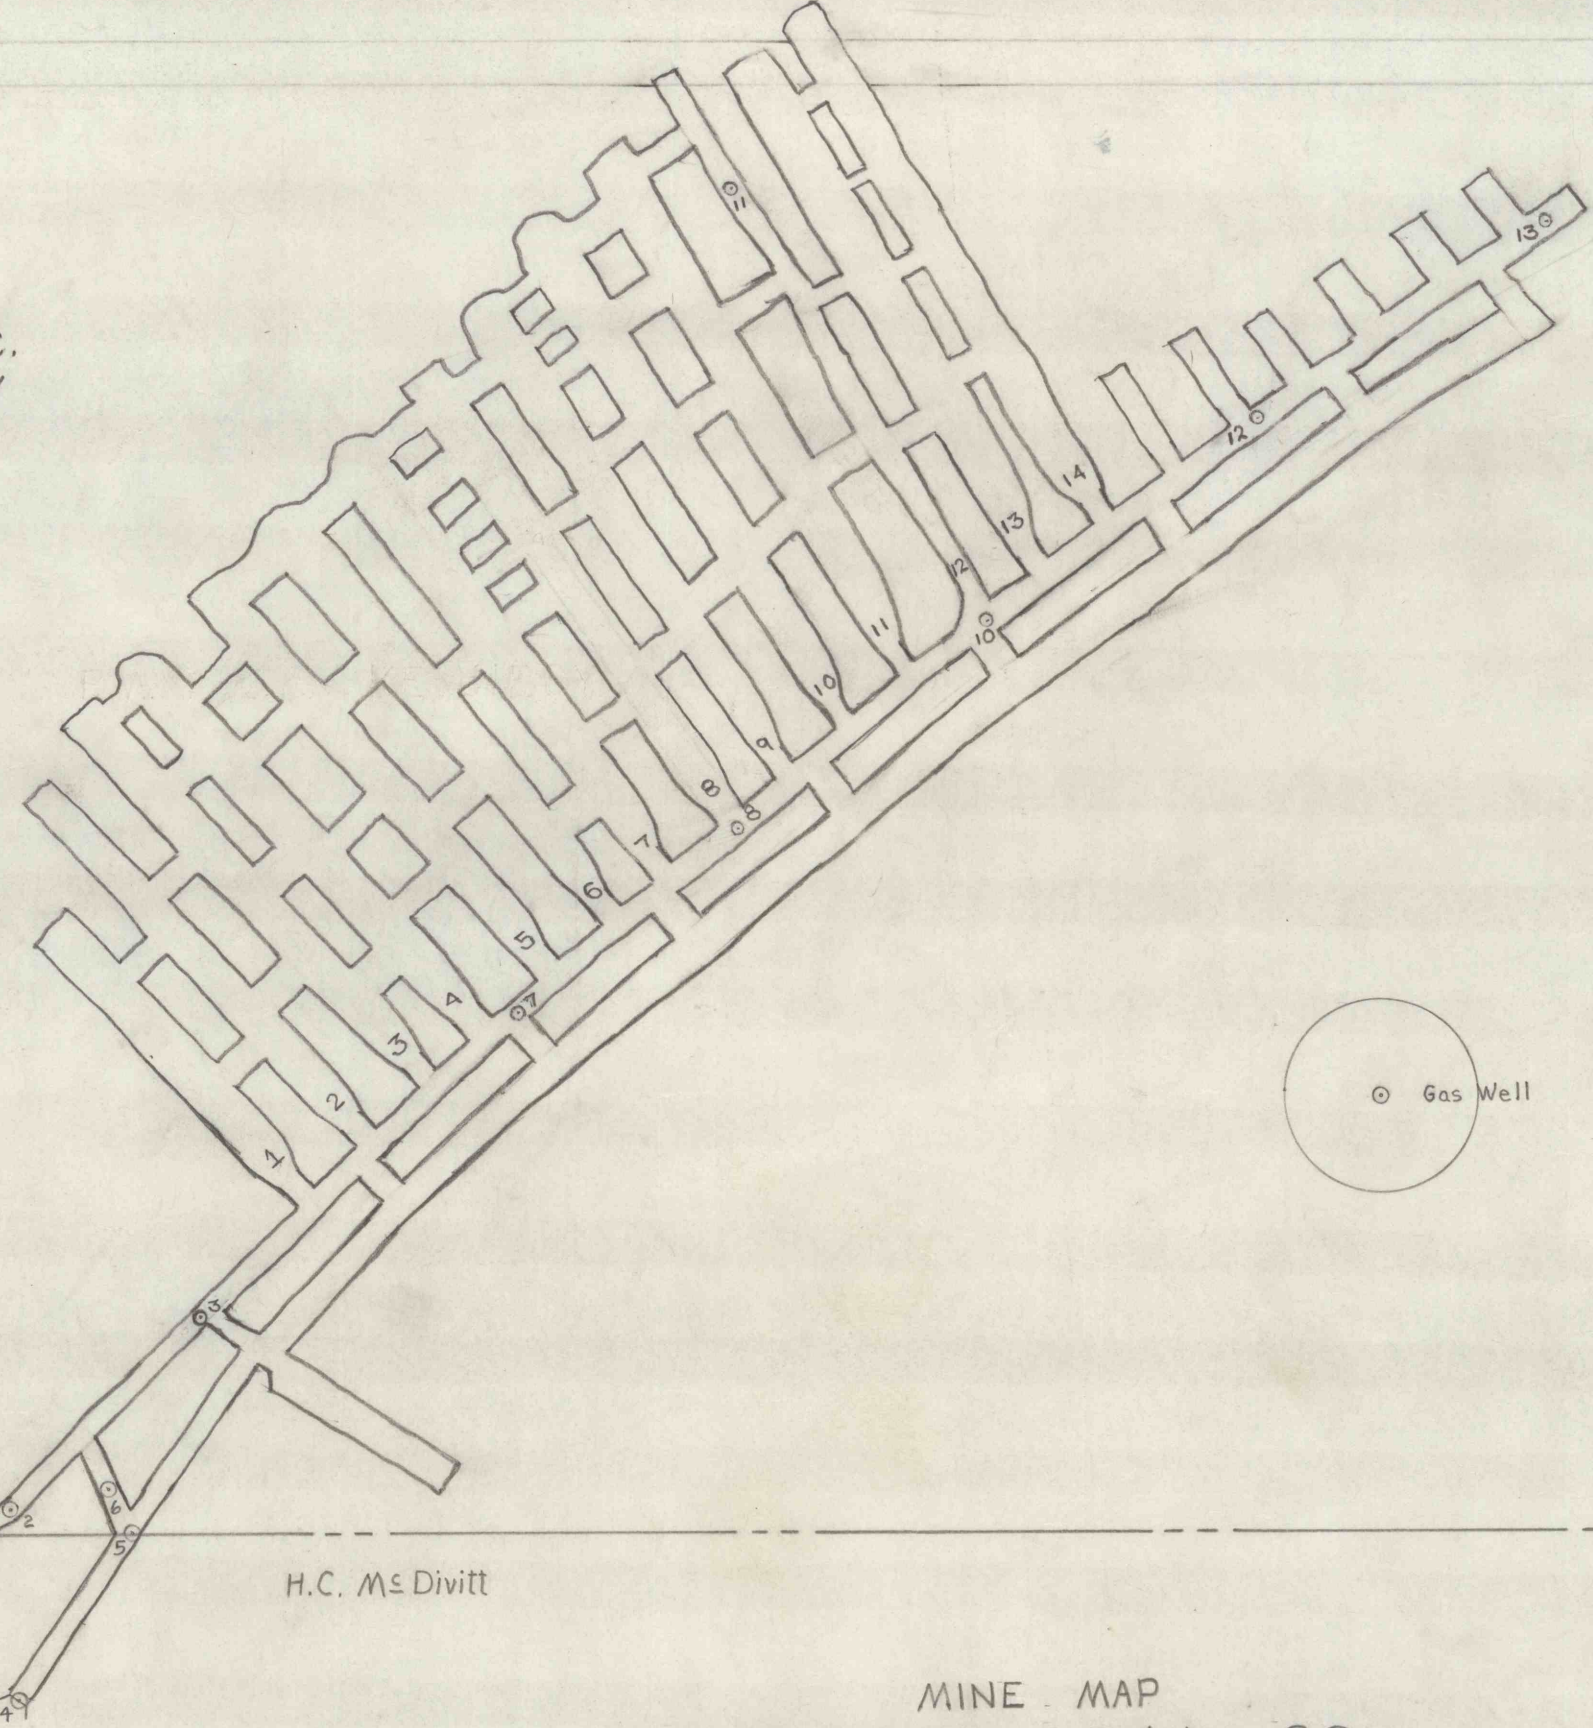

H.C. McDivitt

MINE MAP
FAIRVIEW COAL CO.,
MINE

Porter Township, Jefferson County, Pa.
Scale 1"=100' July 11, 1957
Walter J. Zimmerman - Surveyor-Engineer - Punxsutawney, Pa.

JEFF-157A

FAIRVIEW COAL CO.