


2000'

CLYDE E. DINGER

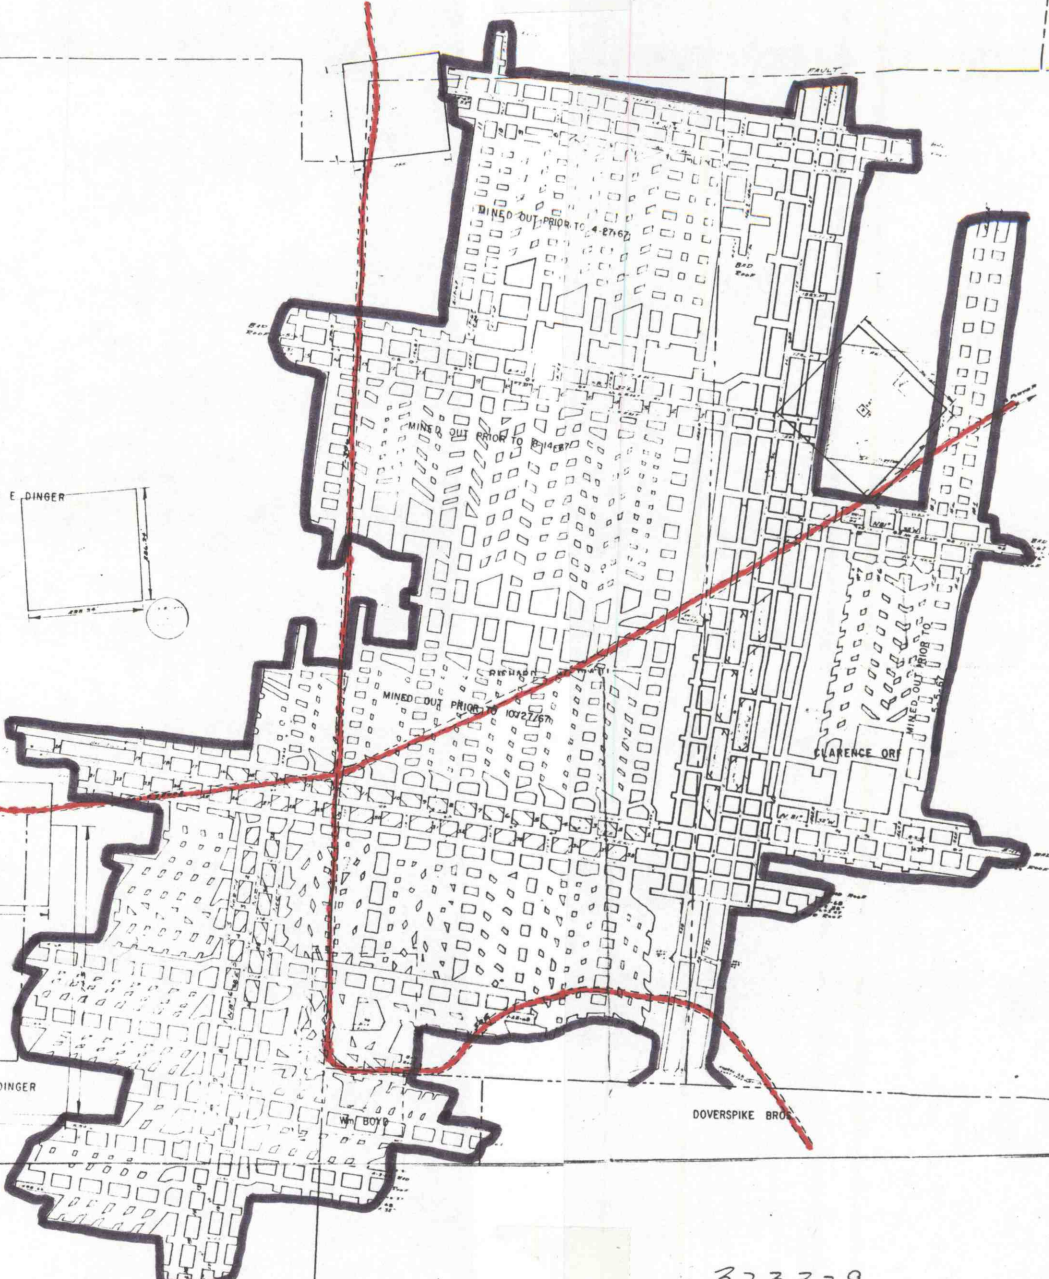

CEMETERY

CLYDE DINGER

LEGEND
 CONTEMPLATED MINING TO 10-27-6 TO 4-27-6
 MINING COMPLETED AREA 3-12-68
 PROTECTED STRUCTURE
 SUPPORT AREA

FINAL MAP
 MINE CLOSED

"D" OR LOWER FREEPORT SEA.

"DORA No. 4" MINE MAP
 DOVERSPIKE BROTHERS COAL CO., INC.
 PORTER TWP., JEFFERSON CO., PENNA.

SCALE: 1" = 100'

0-3-68

REC'D

NYC 896



10-1-68

323329