


- LEGEND**
- CONTEMPLATED MINING TO 10-27-67 TO 4-27-67
 - MINING COMPLETED AREA 9-15-68
 - PROTECTED STRUCTURE
 - SUPPORT AREA

*FINAL MAP
MINE CLOSED*

"D" OR LOWER FREEPORT SEAM

"DORA No. 4" MINE MAP
DOVERSPIKE BROTHERS COAL CO., INC.
PORTER TWP., JEFFERSON CO., PENNA.

SCALE: 1"=100'
9-5-66

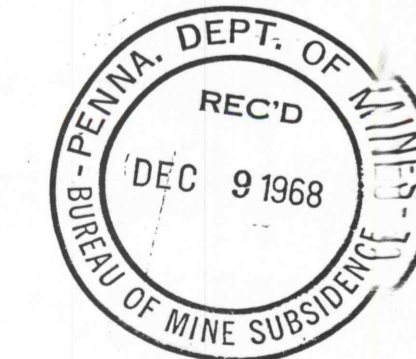

*ack W. Tuller
12-9-68*