




DEPARTMENT OF ENVIRONMENTAL RESOURCES
BUREAU OF MINING
PORTER TOWNSHIP, JEFFERSON COUNTY, PENNSYLVANIA


Very truly yours,
Clyde E. Dinger
Director

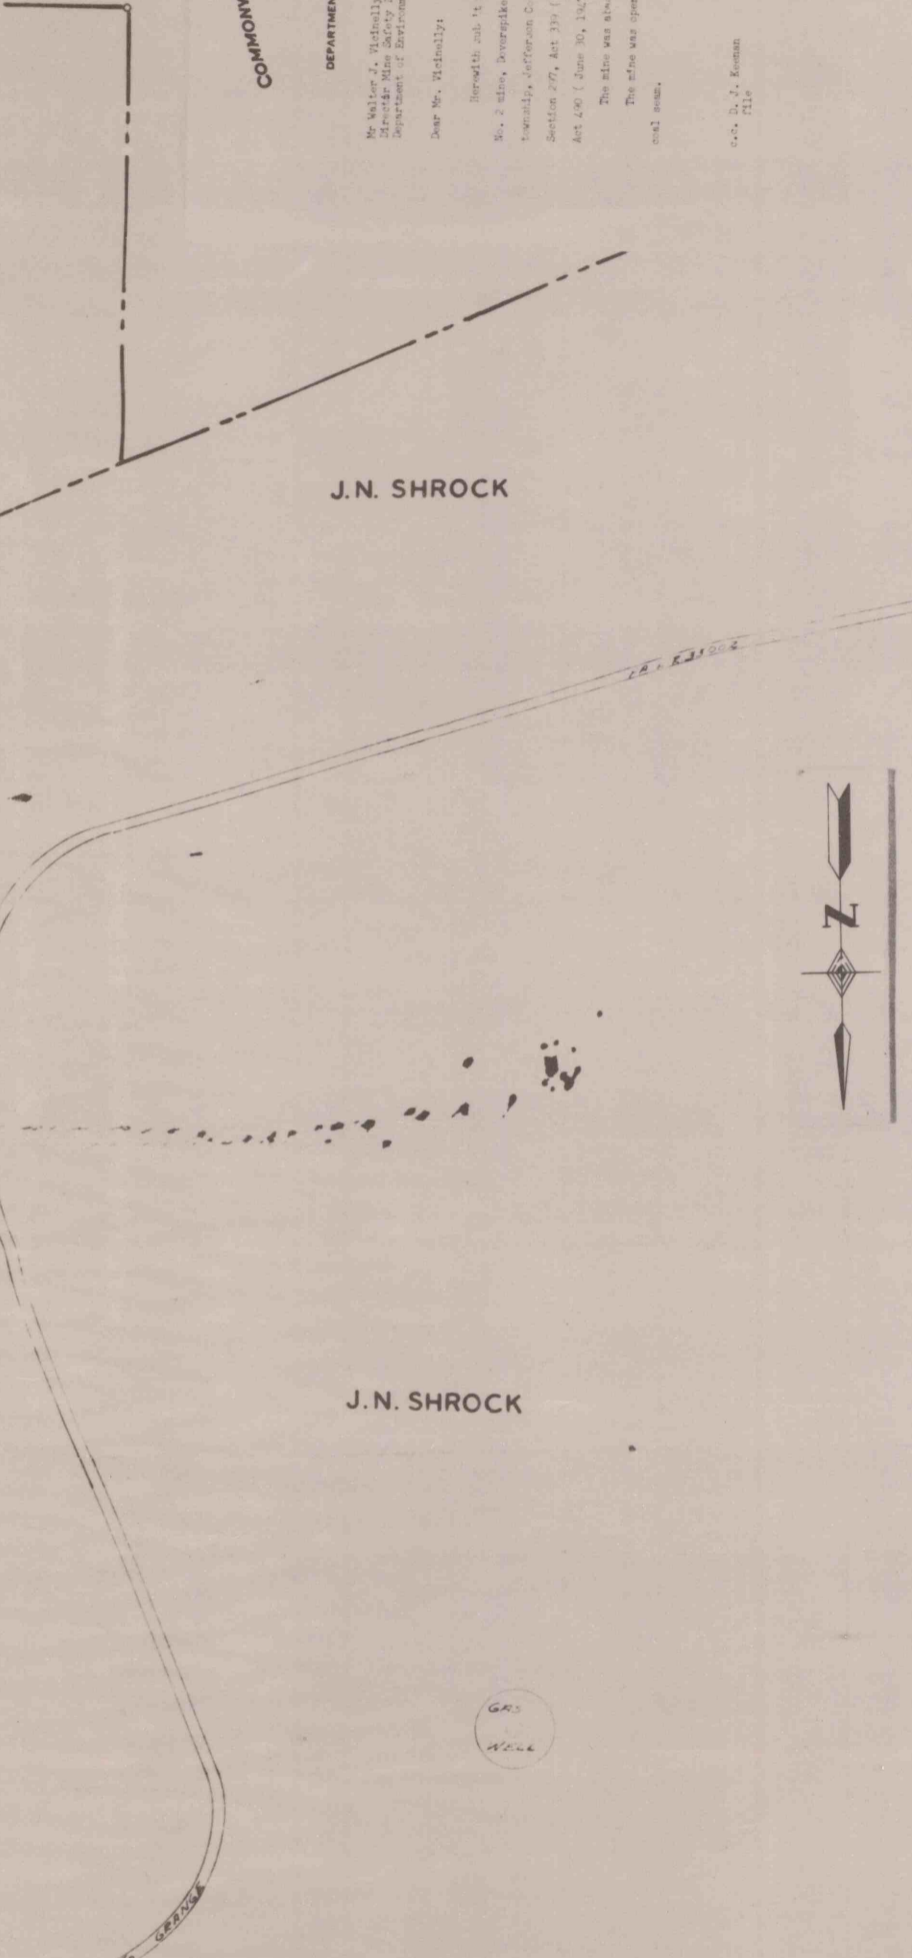

L.W. DINGER

J.N. SHROCK

J.N. SHROCK

ELLIS BARNETT



- DATE OF SURVEY
- AUGUST 16, 1963
- SEPTEMBER 9, 1963
- MARCH 20, 1964
- JULY 16, 1964
- NOVEMBER 17, 1964
- JANUARY 12, 23, 26, 1965
- FEBRUARY 11, 1965
- APRIL 2, 7, 14, 21, 24, 30, 1965
- MAY 4, 14, 21, 26, 1965
- JUNE 7, 8, 9, 10, 12, 15, 18, 22, 25, 30
- JULY 14, 20, 24
- AUGUST 2, 4, 9, 13, 18, 28, 1965

Handwritten notes:
Doverspike Brothers Coal Co.
Porter Twp., Jefferson County
Doverspike Brothers

DOVERSPIKE BROTHERS COAL COMPANY

DORA No. 2 MINE
PORTER TOWNSHIP, JEFFERSON COUNTY, PENNA.
SCALE: 1"=100'

316663

"B" Lower Kittanning Seam