


DUBOIS QUAD Lower Lt. "D" Seam from Photo stat Neg.

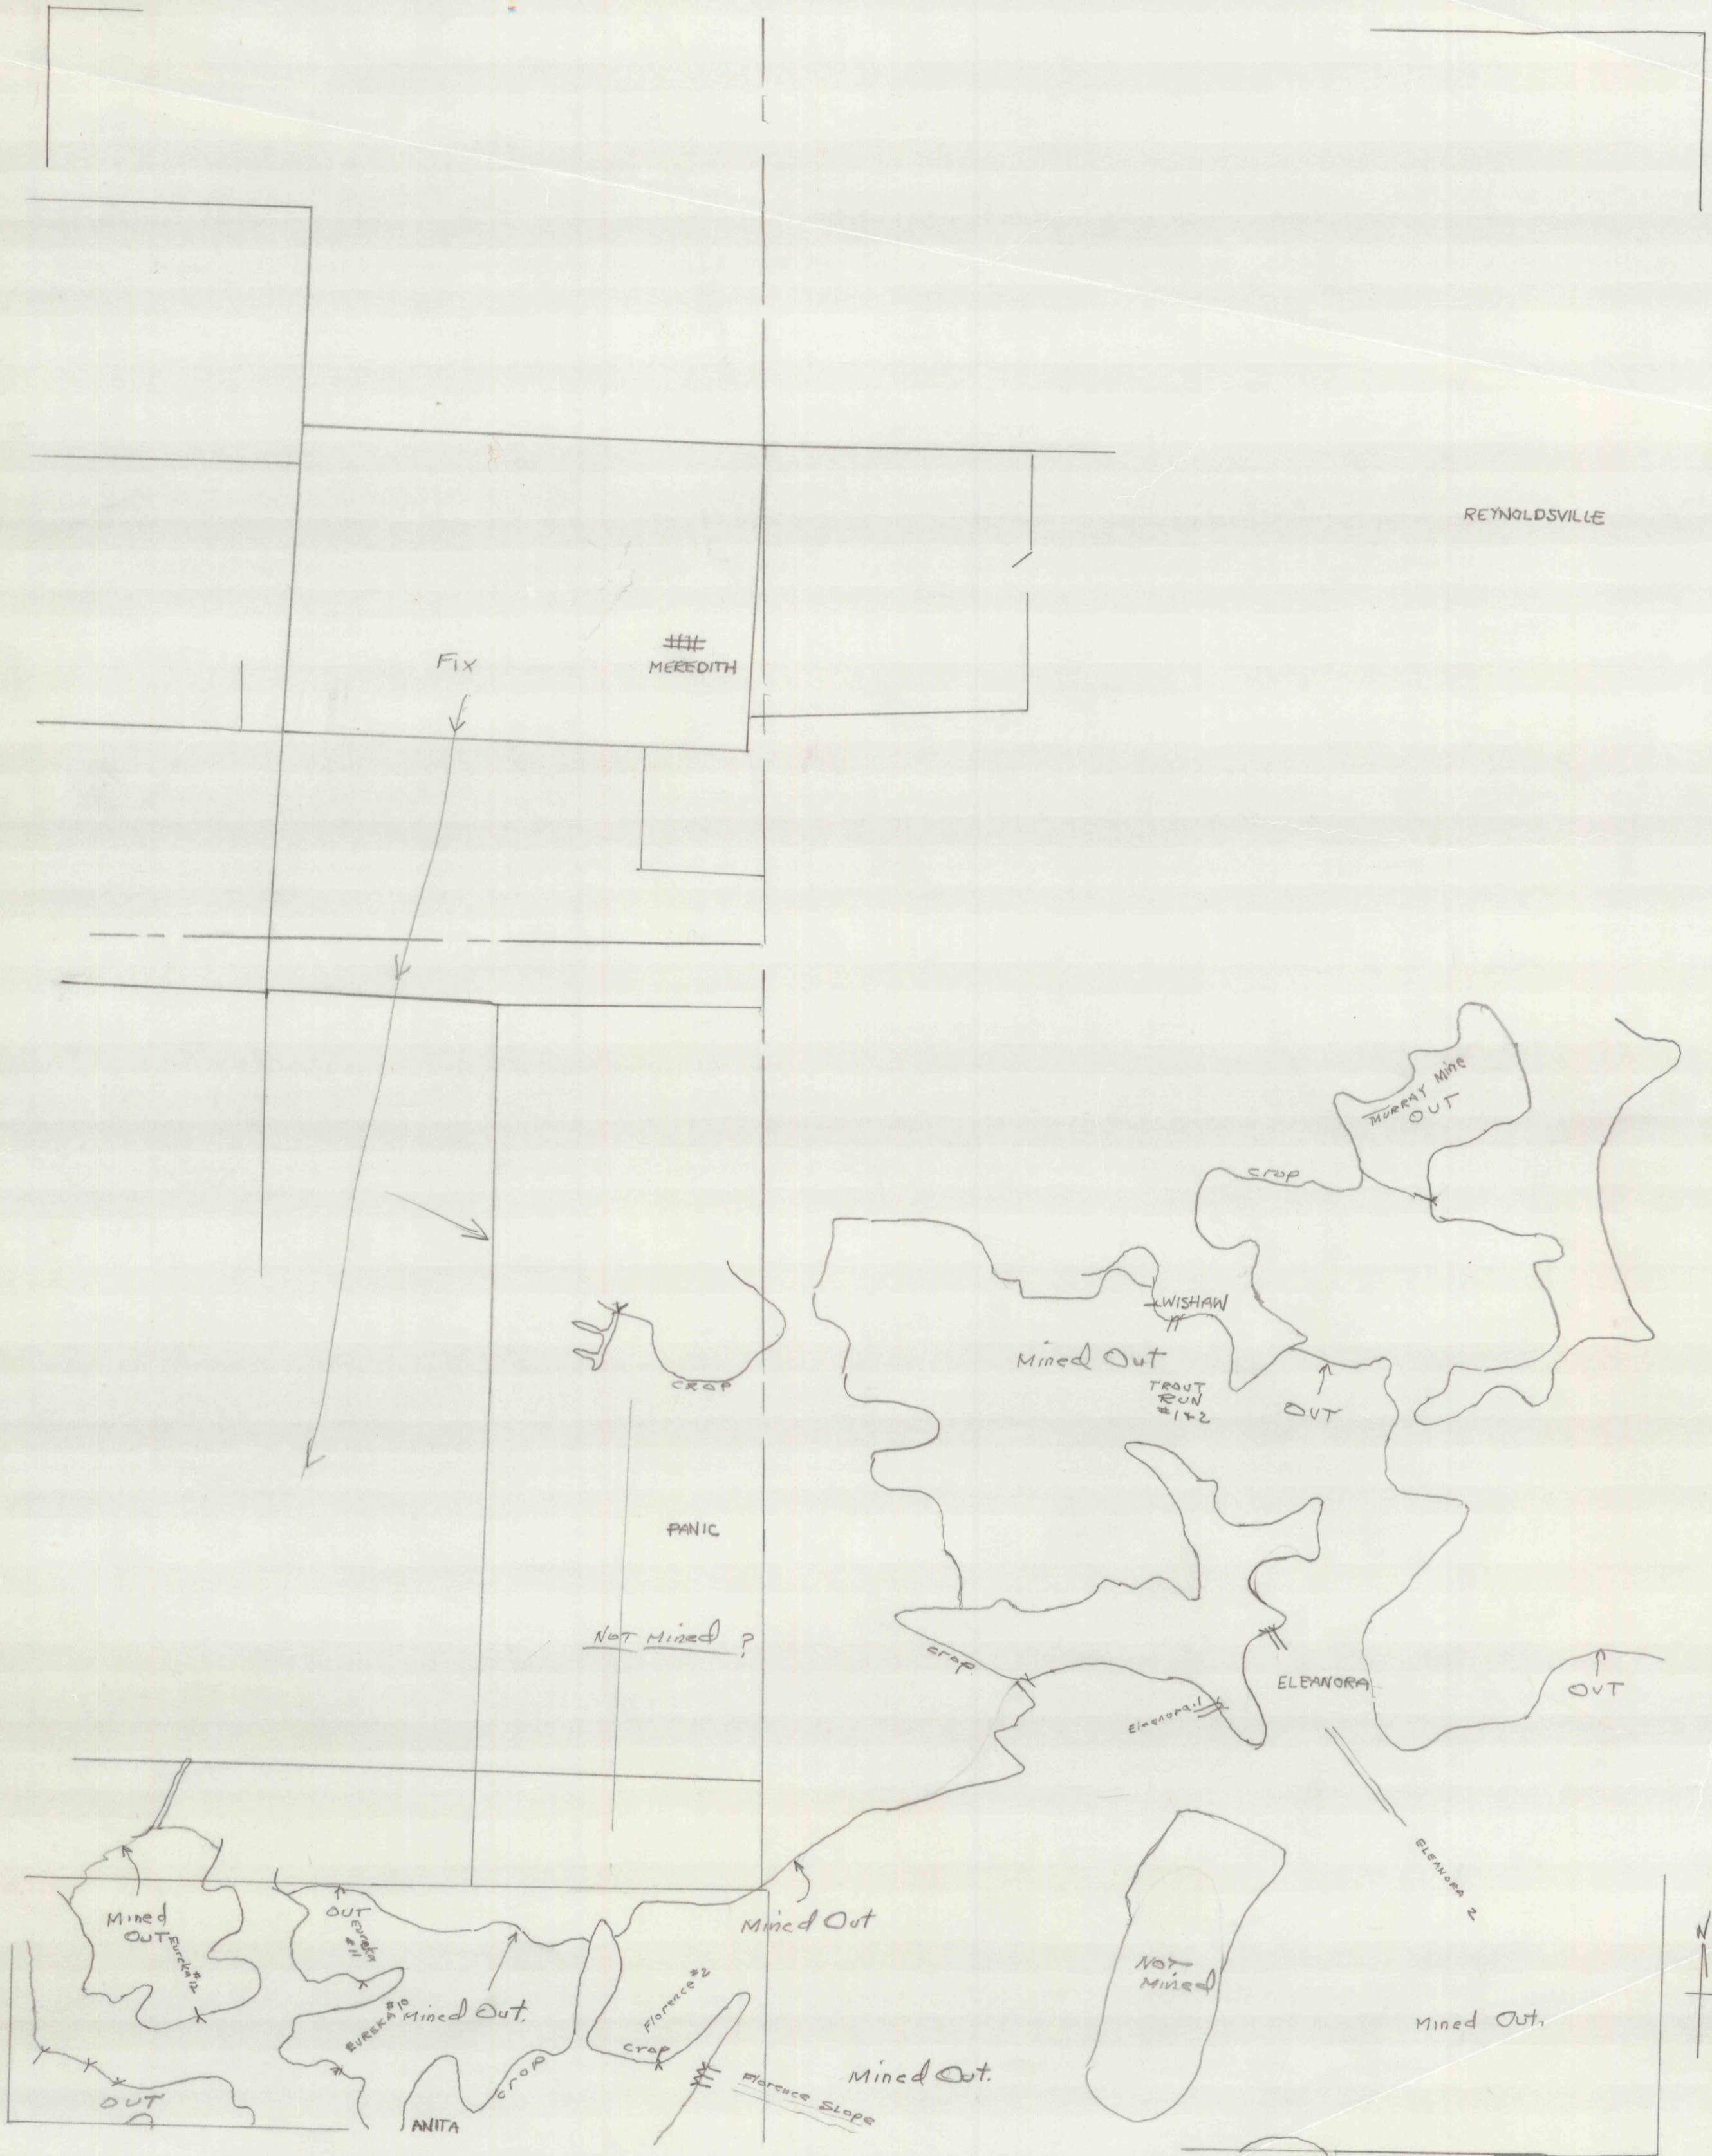

Copied J.C.D. from R.P.P.
1" = 2640'

34