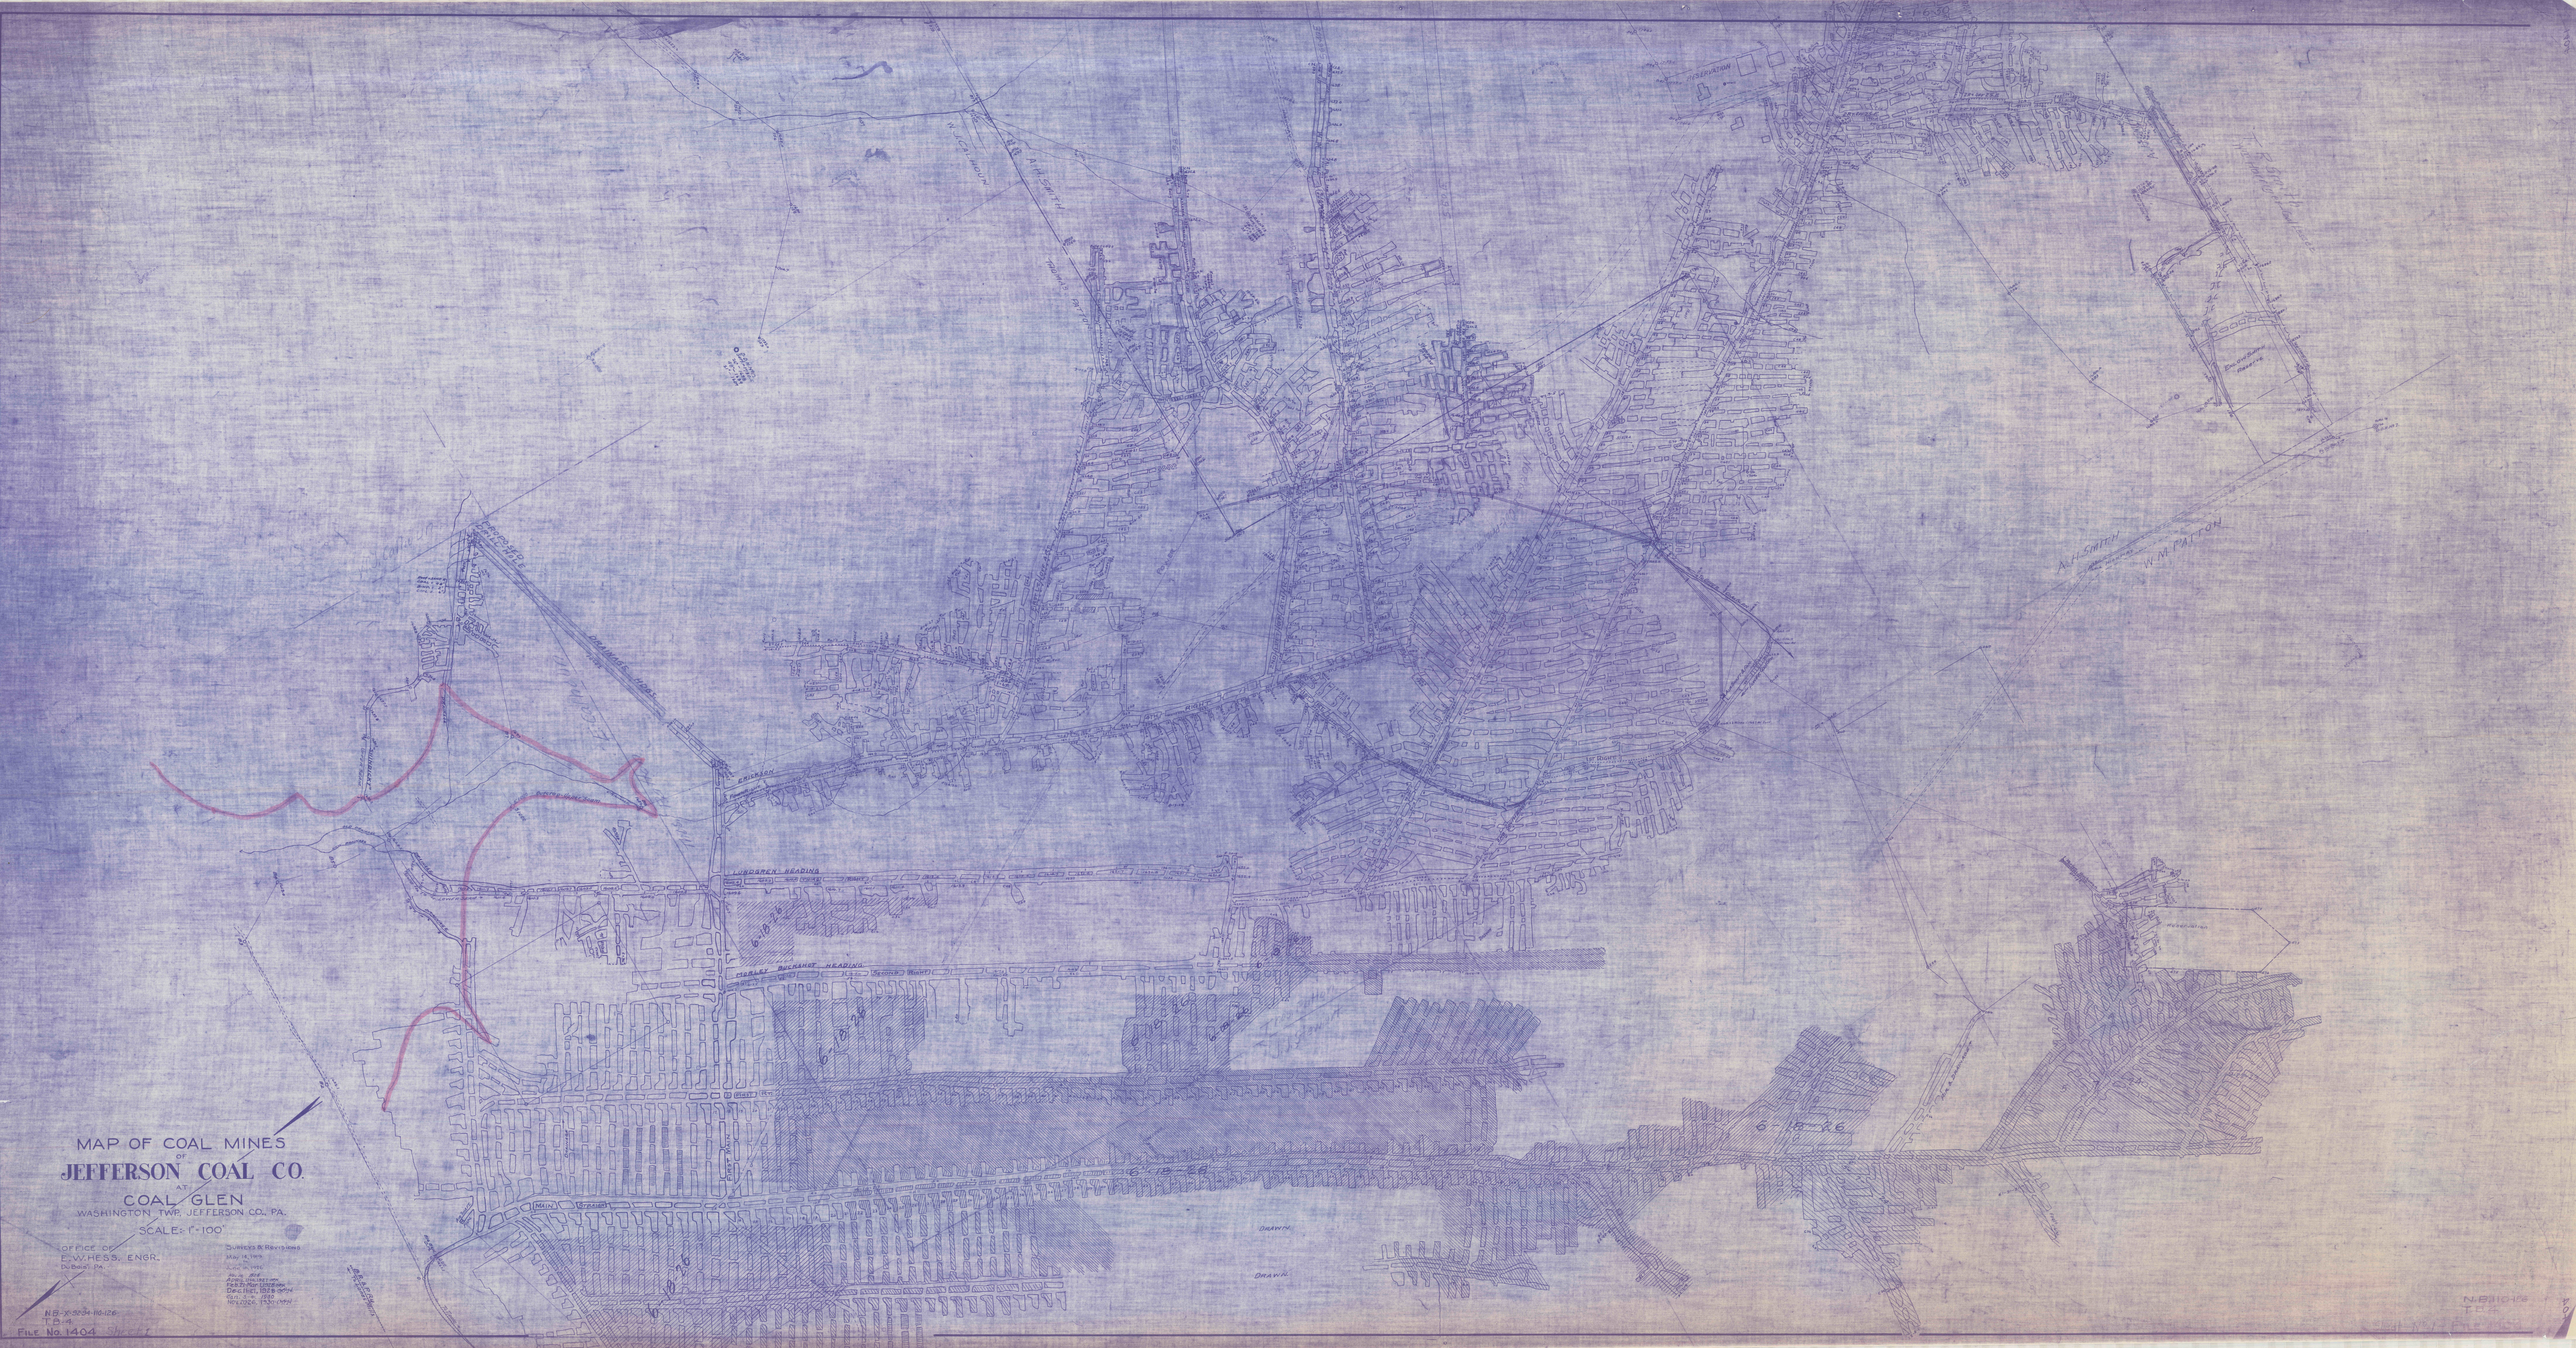
MAP OF COAL MINES
OF
JEFFERSON COAL CO.
AT
COAL GLEN
WASHINGTON TWP. JEFFERSON CO. PA.
SCALE: 1" - 100'
OFFICE OF
P.W. HESS, ENGR.
DuBois, PA.
SURVEYS & REVISIONS
May 18, 1926
Apr. 8, 1927
Aug. 1927
Feb. 27, 1928
Dec. 1st, 1928
Sept. 5th, 1929
Nov. 1926, 1930
N.B. X-30-34-116-126
T.B. 4
FILE No. 1404 Sheet 1
N.B. 116-126
T.B.
DRAWN
6-18-26
6-19-26
6-20-26
LUNDAREN HEADING
MAIN
CRESCENT
DRAINAGE DITCH
A.J. SMITH
W.M. PATTON