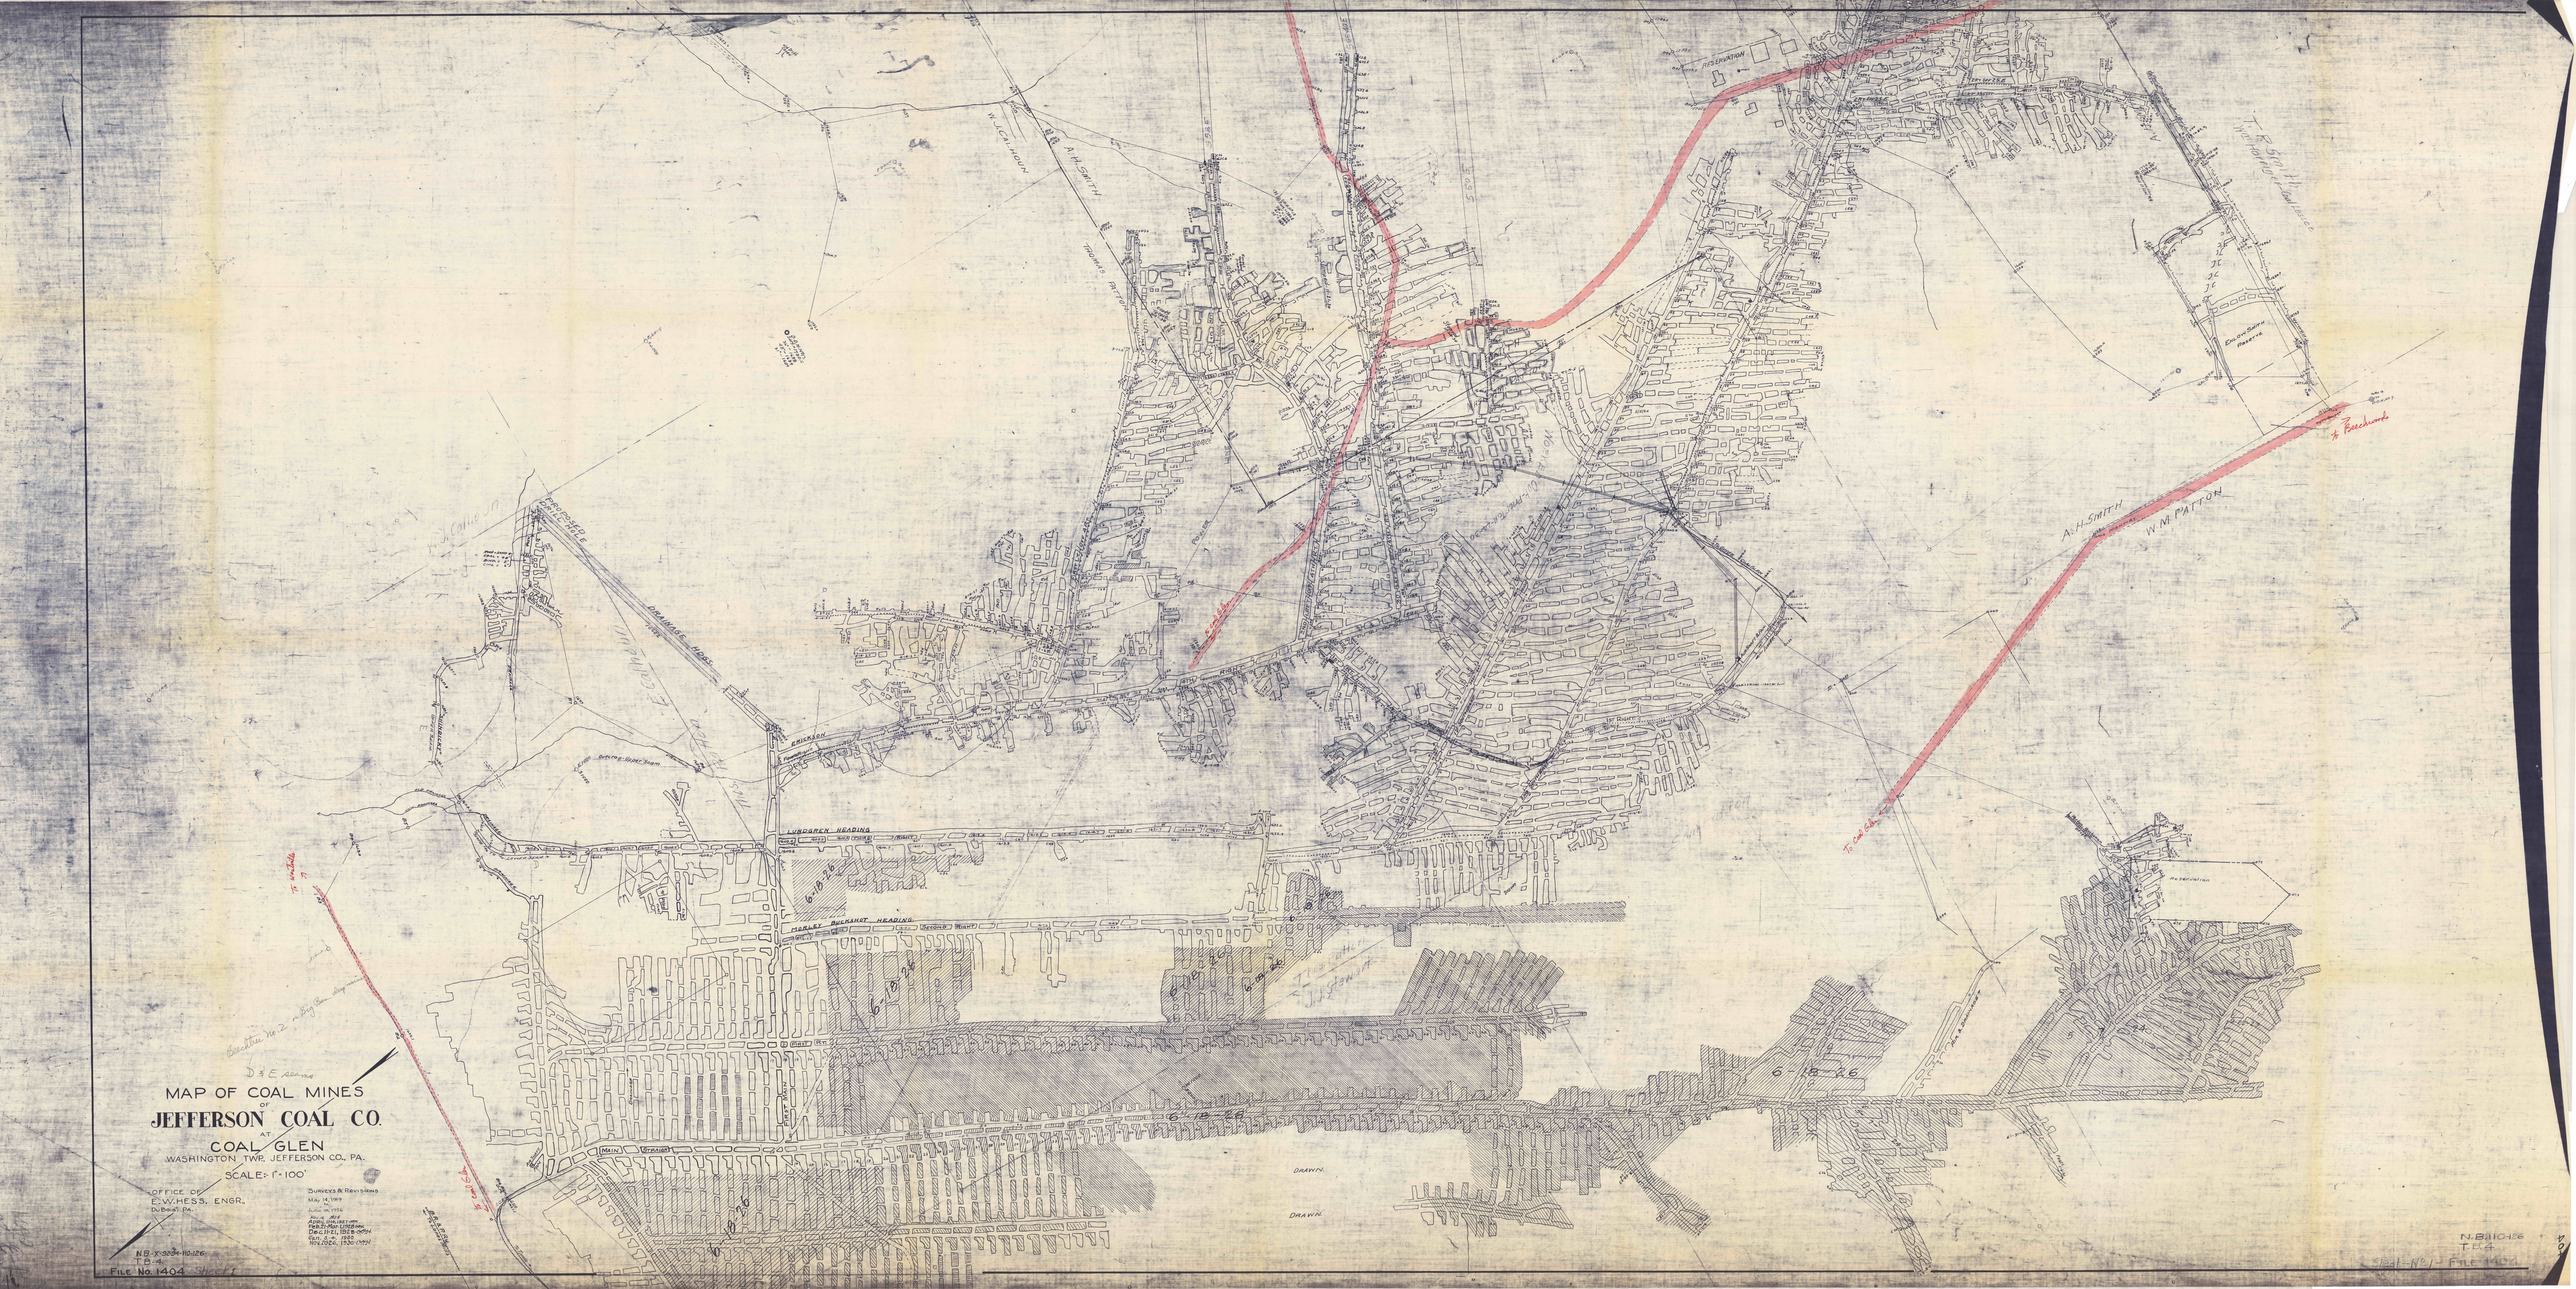

W. C. CALHOUN
A. H. SMITH
RESERVATION
2 RT. OFF 2 S.E.
T. R. Smith
Wm Harringer Coal Lessee
ENLOW SMITH Reserve
to Beechwoods
A. H. SMITH
W. M. PATTON
STATE HIGHWAY
To Coal Glen
W. J. Calhoun
PROPOSED DRILL HOLE
DRAINAGE HDGS.
E. Calhoun
"SHINDICKY" UPPER SEAM.
Outcrop-Upper Seam.
OLD DRAINAGE
NEW DRAINAGE
DRAINAGE
LOWER SEAM
ERICKSON
FOURTH RIGHT
4TH RIGHT
POWER LINE
FIRST LT. OFF ART.
2ND LEFT OFF 4TH RT.
LUNDGREN HEADING
THIRD RIGHT
MORLEY BUCKSHOT HEADING
SECOND RIGHT
FIRST RT.
MAIN STRAIGHT
6-18-26
DRAWN
Reservation
To Westville
AIR SHAFT - FAN
BIG BEN D.M.
B.R.&P. R.Y. To Lanes Mills
To Tipple
To Coal Glen

Beechtree No. 2 or Big Ben deep mine

D & E seams

MAP OF COAL MINES
OF
JEFFERSON COAL CO.
AT
COAL GLEN
WASHINGTON TWP., JEFFERSON CO., PA.

SCALE:- 1" = 100'

OFFICE OF
E. W. HESS, ENGR.,
DuBois, PA.

SURVEYS & REVISIONS
May 14, 1919
to
June 18, 1926
Nov. 16, 1926
April 11-14, 1927 O.O.H.
Feb. 21-Mar. 1, 1928 O.O.H.
Dec. 11-21, 1928 O.O.H.
Jan. 3-4, 1930
Nov. 20-26, 1930 O.O.H.

N.B.-X-92-94-110-126-
T.B.-4.
FILE NO. 1404 Sheet 1

N. B. 110-126
T. B. 4
Sheet - No. 1 - FILE 1404