

PANTHER RUN COAL COMPANY
"PANTHER RUN MINE"
(~~"A" OR BROOKVILLE SEAM~~)
B


PARDUS,
WASHINGTON TOWNSHIP
JEFFERSON COUNTY

FILED

CABINET - "I"
DRAWER No. 1
ABANDONED - APRIL 8, 1925

323388

PDVMS
03065 449 30X 323388

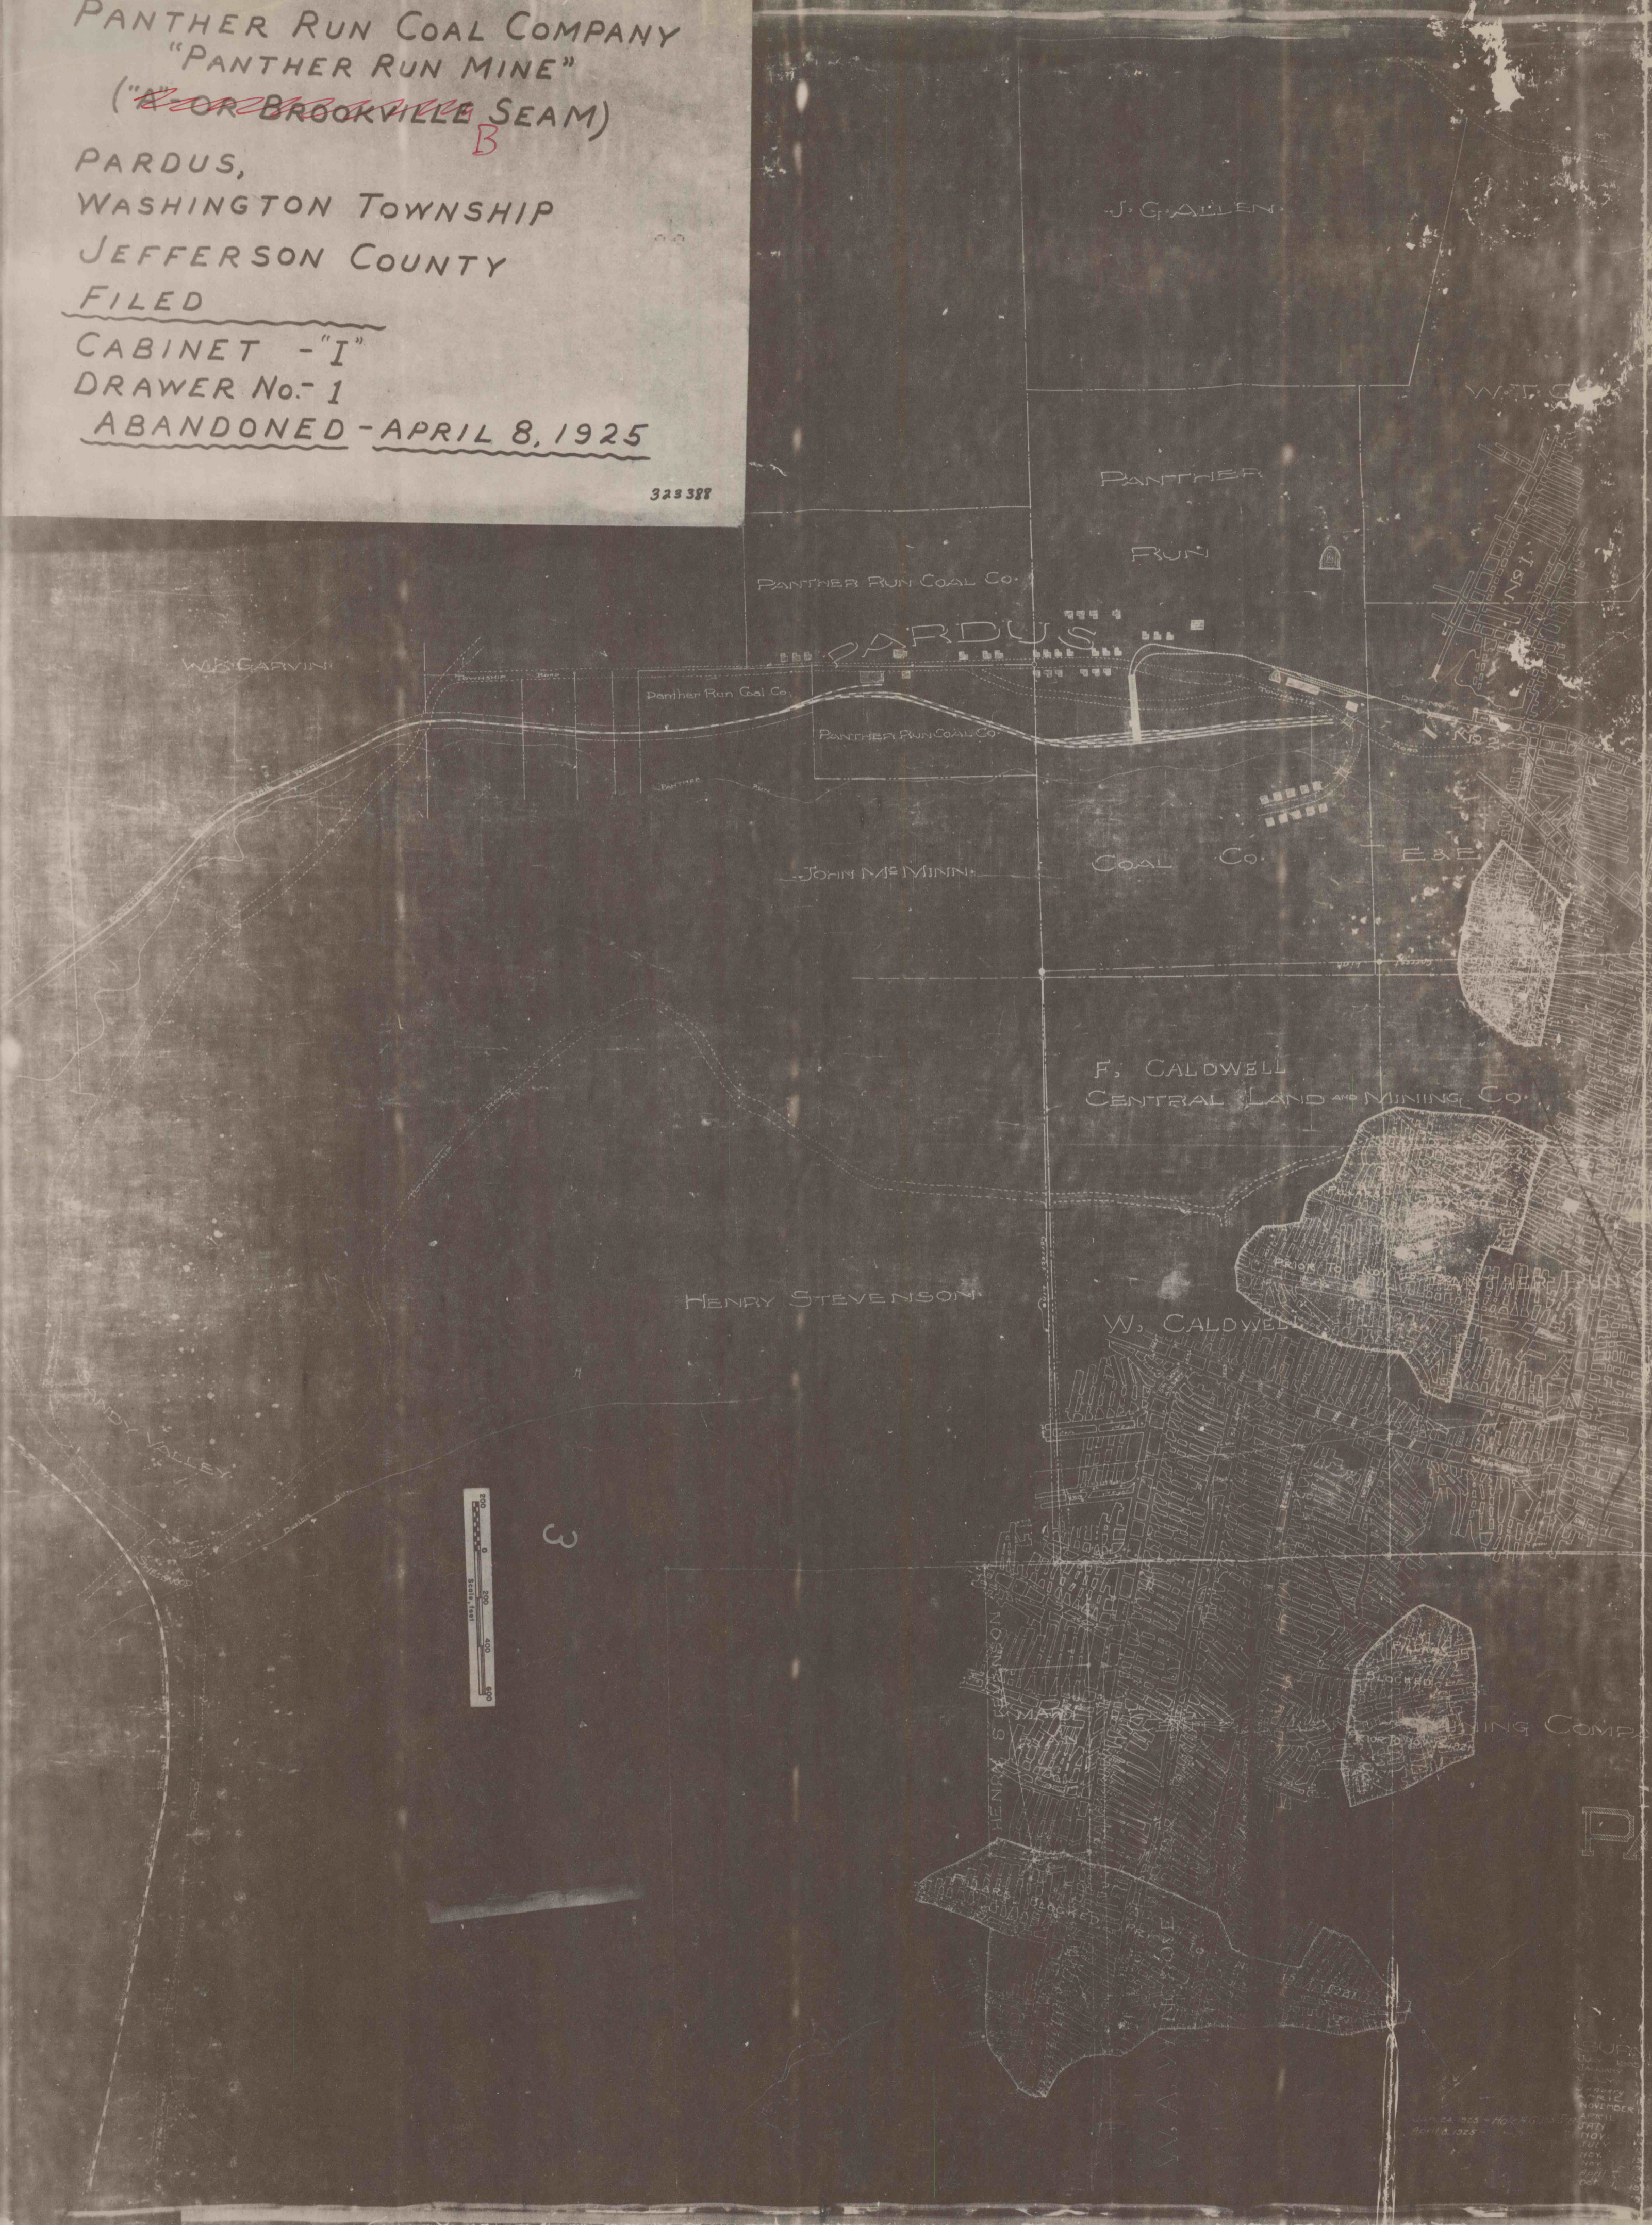

NOVEMBER
1925