


Adrian Mine C=400'

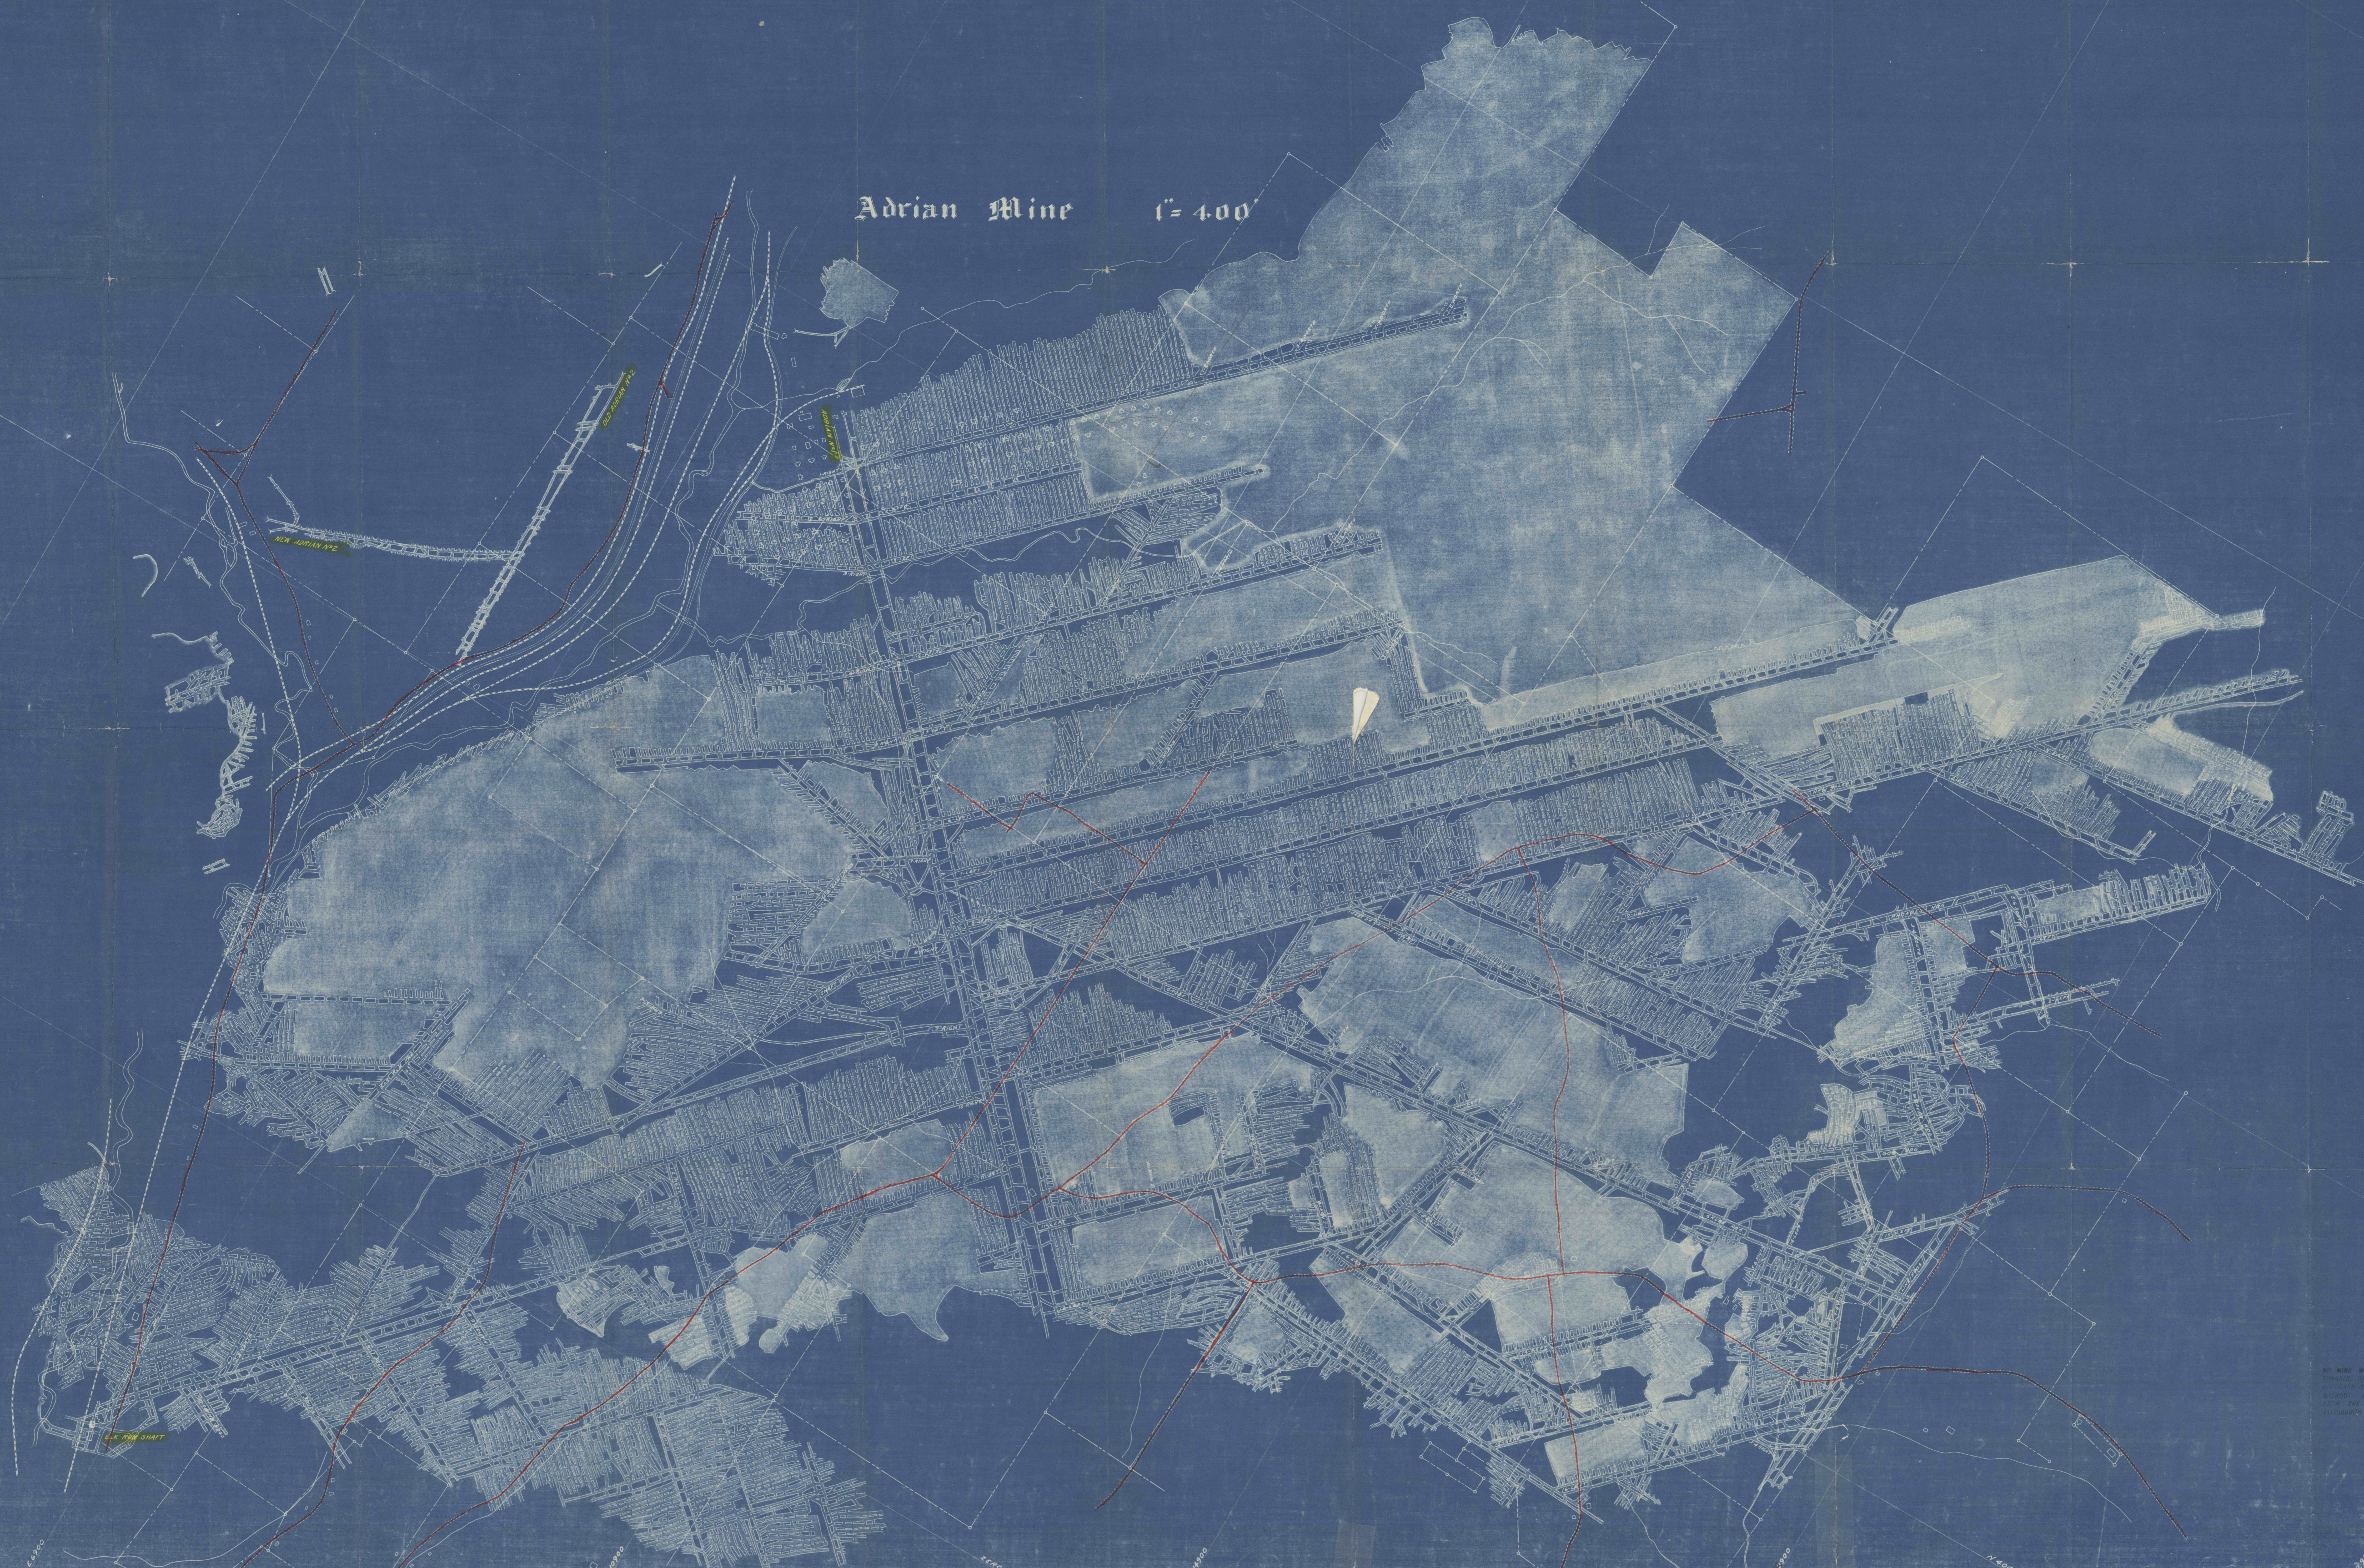

NOTE:
ADRIAN MINE WORKINGS SHOWN INCLUDES ALL WORKINGS
KNOWN TO EXIST AS OF THE DATE OF THE SURVEY
AND ARE NOT NECESSARILY ALL THE WORKINGS
WHICH MAY BE FOUND IN THE MINE.