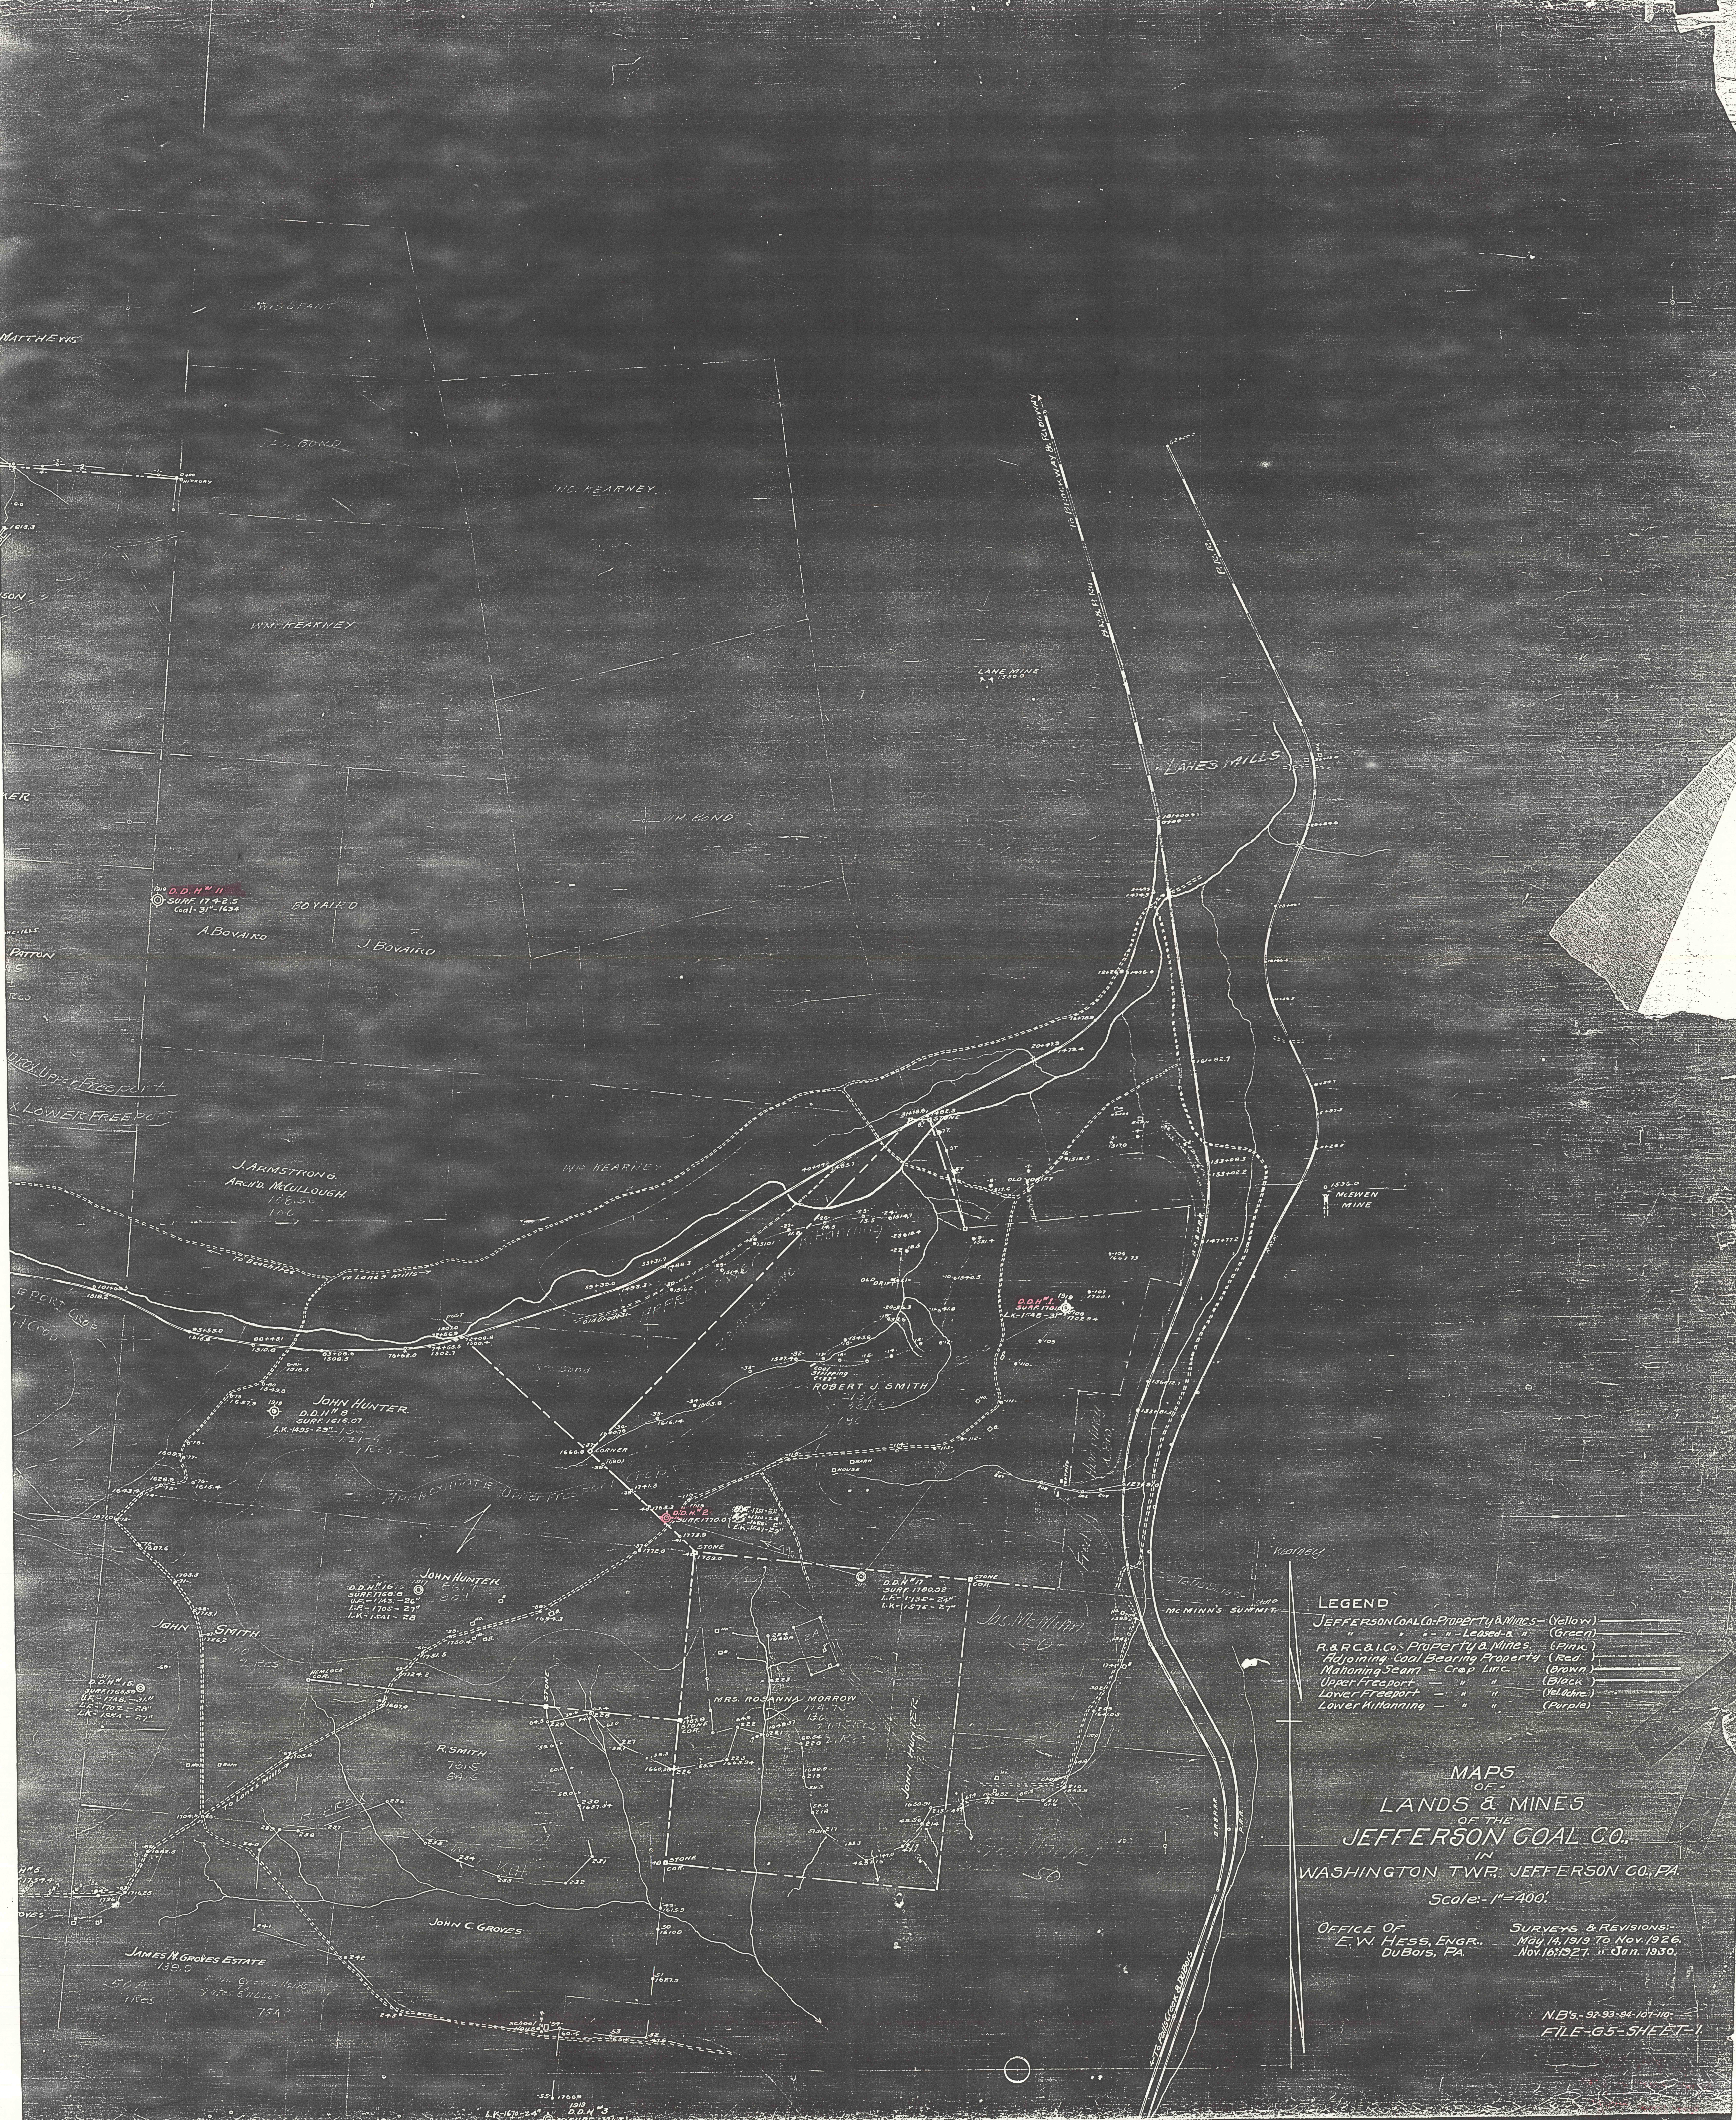
Lewis Grant
Matthews
Jas. Bond
Nickory
Jno. Kearney
Wm. Kearney
Lane Mine
1550.0
To Brockway & Ridgway
B.R.&P. R.R.
P.R.R.
Lanes Mills
Wm. Bond
D.D.H. No 11
Surf. 1742.5
Coal - 31" - 1634
Boyaird
A. Bovaird
J. Bovaird
Patton
Approx. Upper Freeport
Approx. Lower Freeport
J. Armstrong
Arch'd. McCullough
Wm. Kearney
To Beechtree
To Lanes Mills
Post
Old Grade
Approx. Lower Kittanning
Kittanning
Old Drift
Stone
McEwen Mine
1536.0
D.D.H. No 1
Surf. 1701
LK - 1548 - 31"
Robert J. Smith
Coal Stripping C-22"
John Hunter
D.D.H. No 8
Surf. 1616.07
L.K. - 1495 - 29"
Corner
Approximate Upper Freeport Crop
D.D.H. No 2
Surf. 1770.0
Barn
House
D.D.H. No 16
Surf. 1768.8
U.F. - 1743 - 26"
L.F. - 1705 - 27"
L.K. - 1541 - 28
John Hunter
John Smith
D.D.H. No 15
Surf. 1765.59
U.F. - 1748 - 31"
L.F. - 1702 - 28"
L.K. - 1554 - 27"
Hemlock Cor.
Stone Cor.
Mrs. Rosanna Morrow
R. Smith
To Lanes Mills
D.D.H. No 17
Surf. 1780.52
L.F. - 1735 - 24"
L.K. - 1575 - 27"
Jas. McMinn
50
McMinn's Summit
To DuBois
Kearney
John Hunter
Geo. Hunter
50
John C. Groves
James M. Groves Estate
139.9
School House
D.D.H. No 3
L.K. - 1670 - 24"
B.R.&P. R.R.
P.R.R.
To Falls Creek & DuBois

LEGEND

Jefferson Coal Co. Property & Mines -	(Yellow)
" " " - " - Leased - "	(Green)
R.&P.C.&I. Co. Property & Mines.	(Pink)
Adjoining Coal Bearing Property	(Red)
Mahoning Seam - Crop Line	(Brown)
Upper Freeport - " "	(Black)
Lower Freeport - " "	(Yel. Ochre)
Lower Kittanning - " "	(Purple)

MAPS
OF
LANDS & MINES
OF THE
JEFFERSON COAL CO.
IN
WASHINGTON TWP. JEFFERSON CO., PA.

Scale:- 1" = 400'.

Office Of
E. W. Hess, Engr.,
DuBois, Pa.

Surveys & Revisions:-
May 14, 1919 To Nov. 1926.
Nov. 16, 1927 " Jan. 1930.

N.B's.- 92-93-94-107-110-
FILE-G5-SHEET-1.