


FULLER

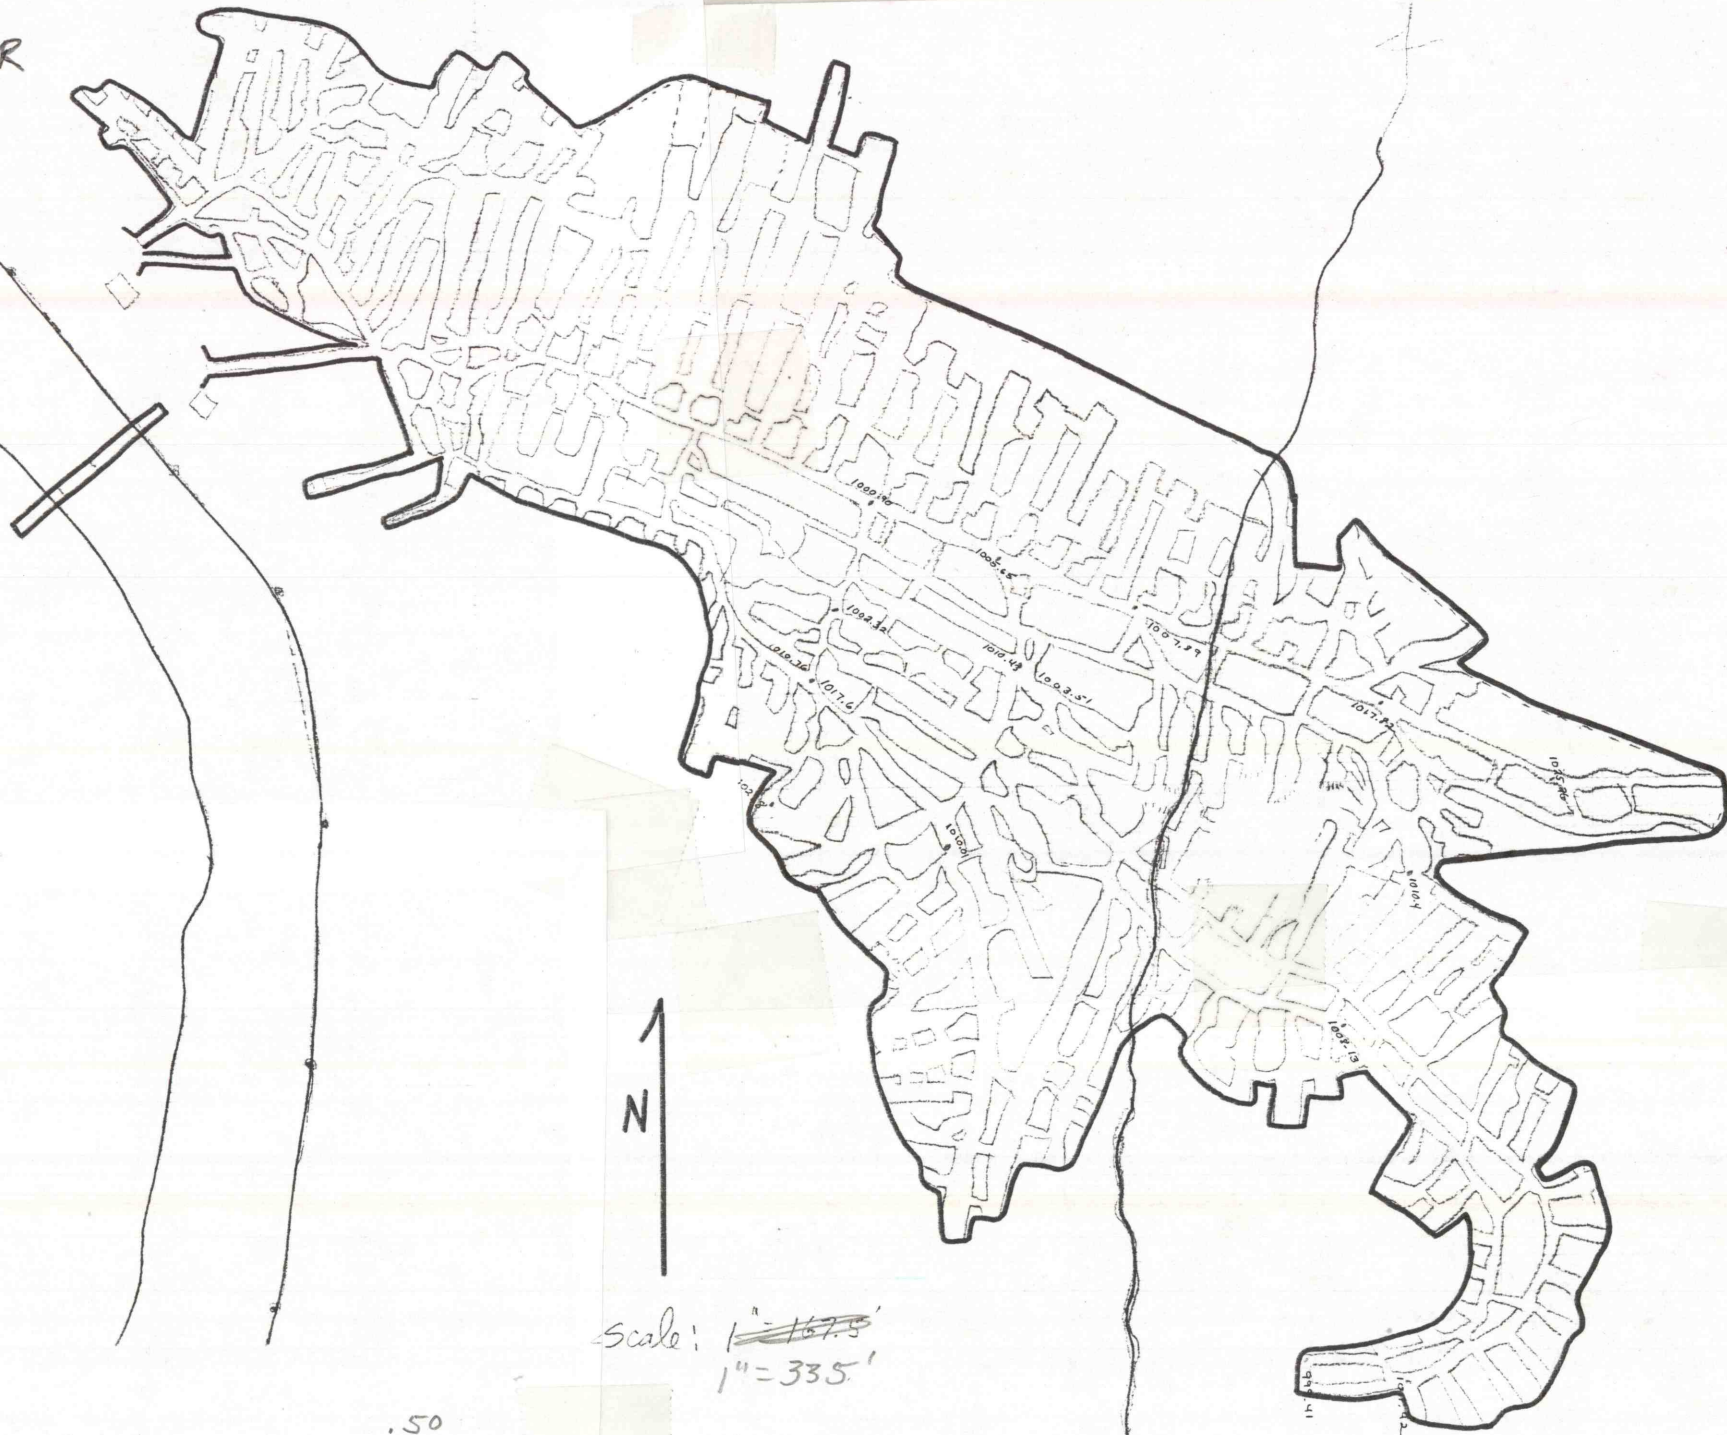

2000'

N

Scale: 1" = 167.5'
1" = 335'

.50
.50
.67

1019.2-7