


STRAITIFF mine
(see other sheet)

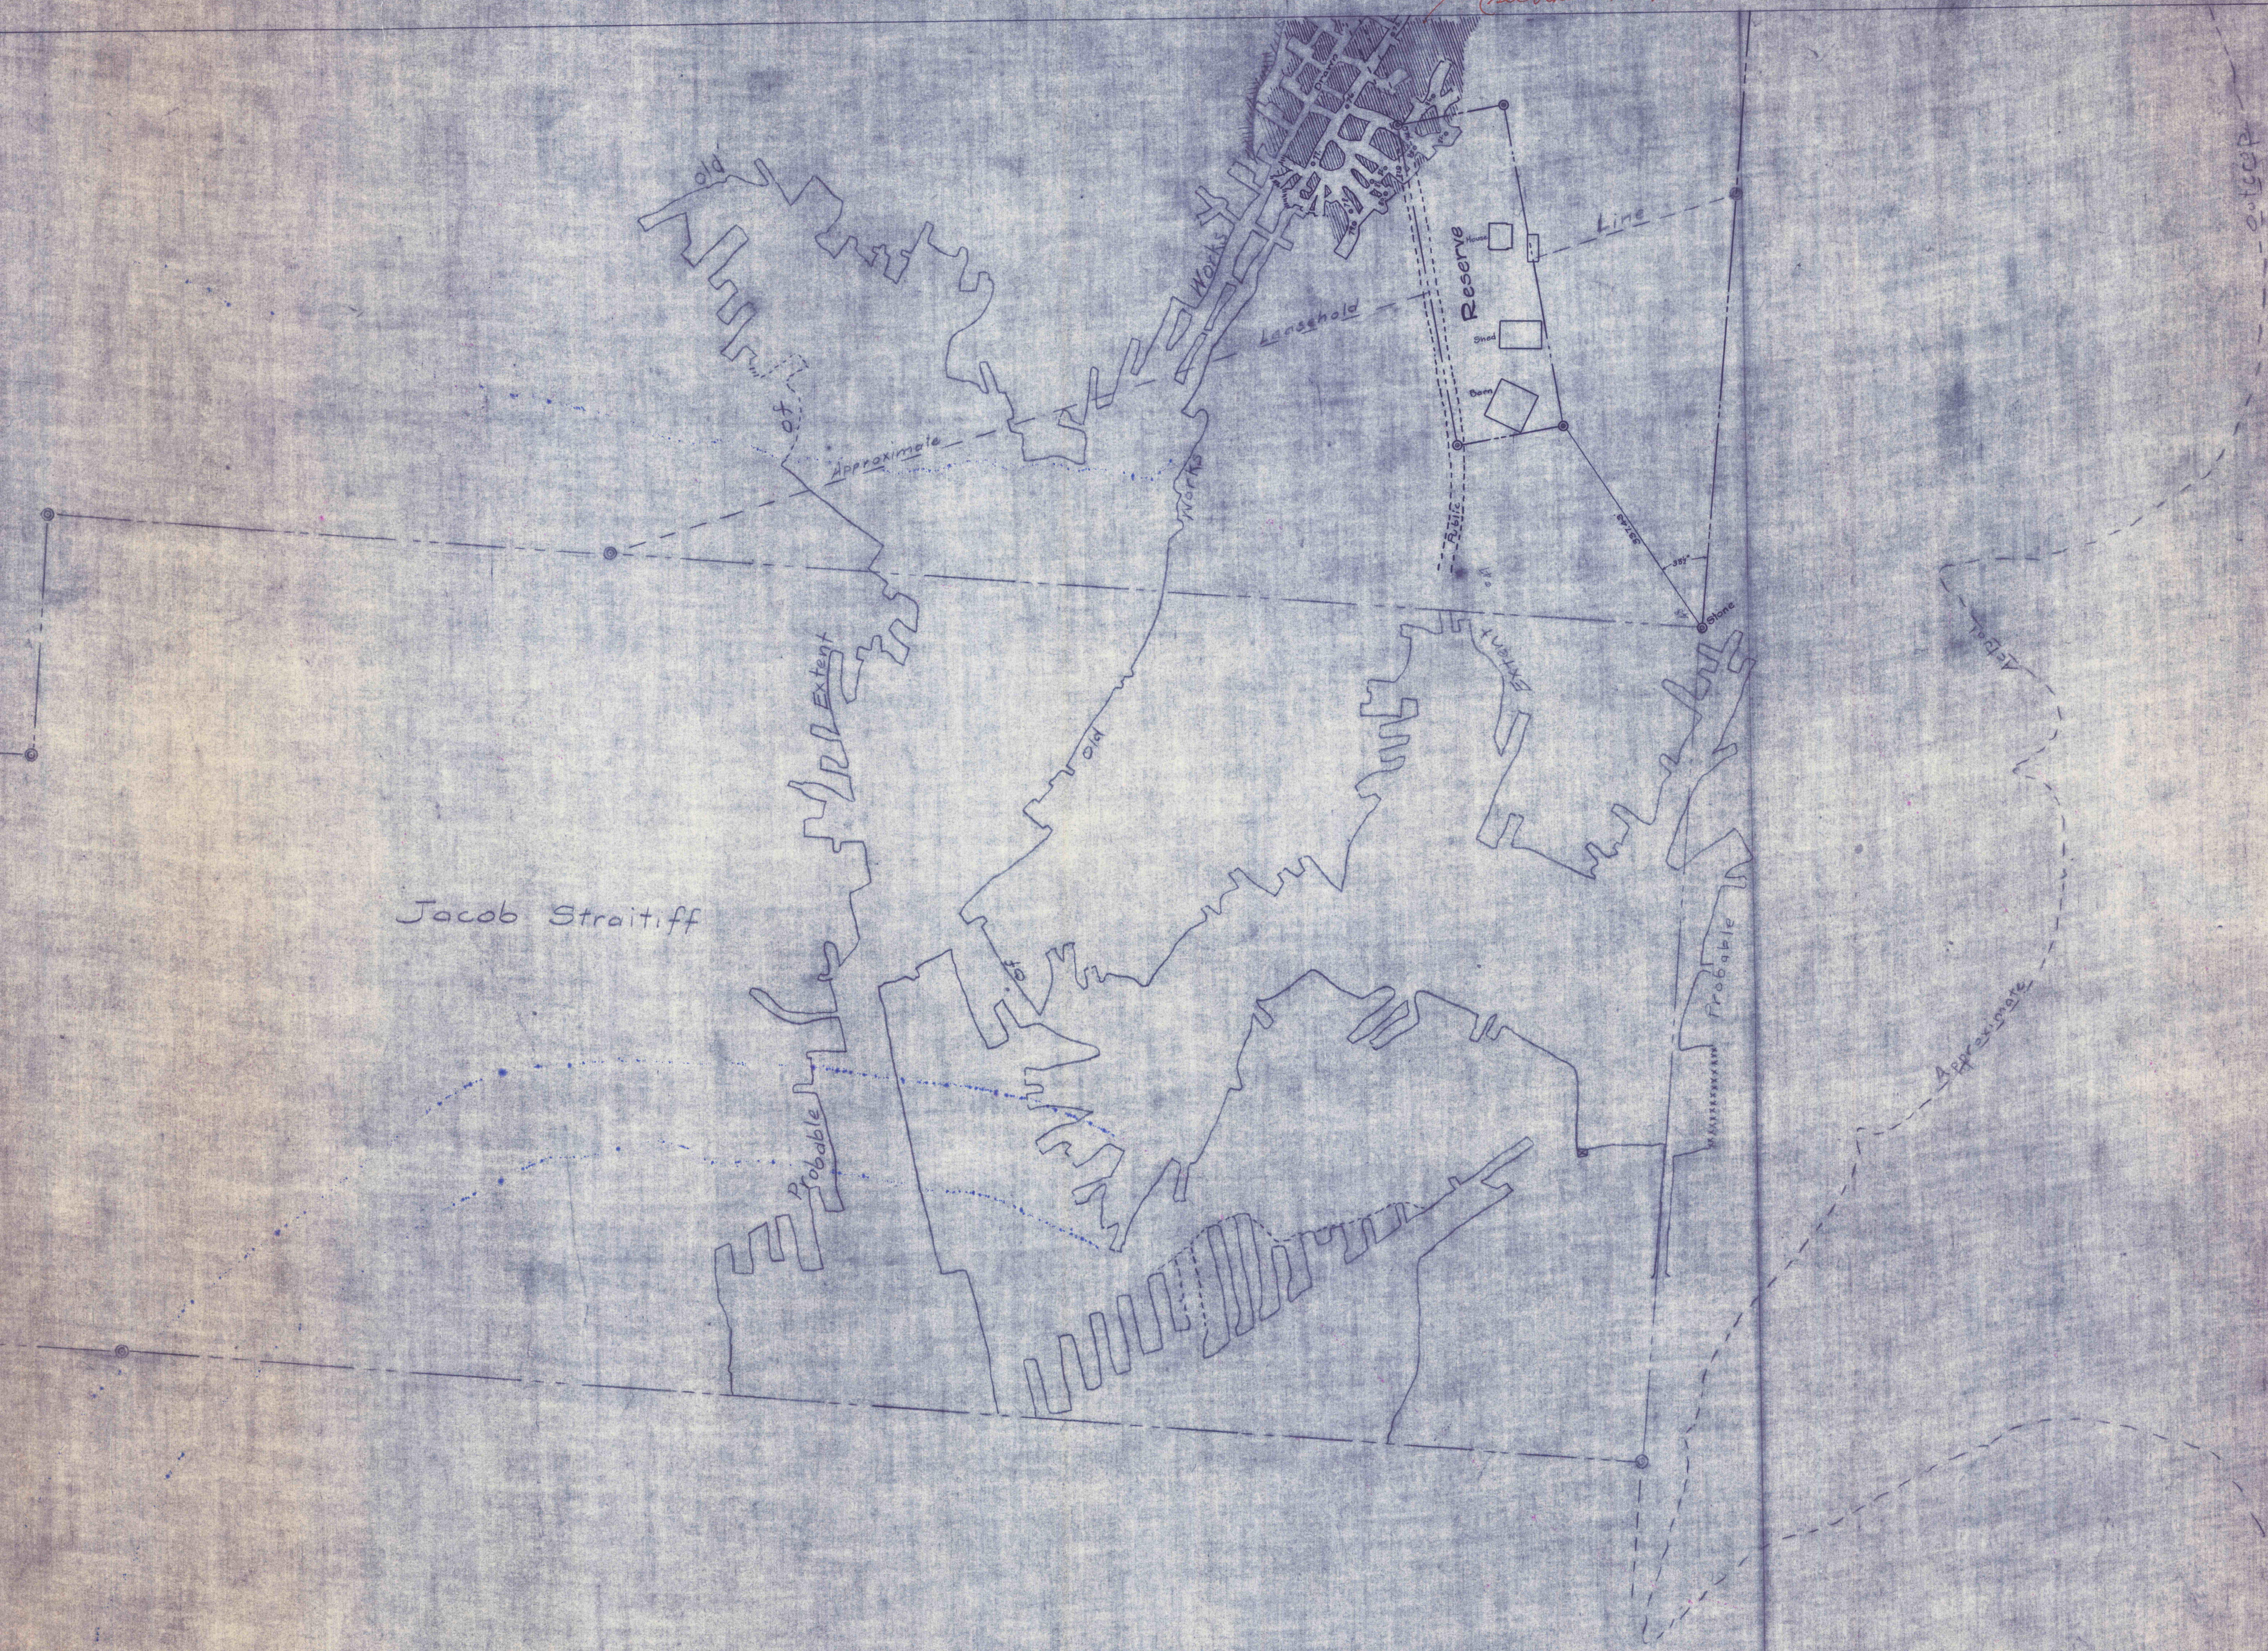

Jacob Straitiff

1" = 100'

Straitwell Coal Co.
Mc Calmont top, Jefferson County

1000000 W