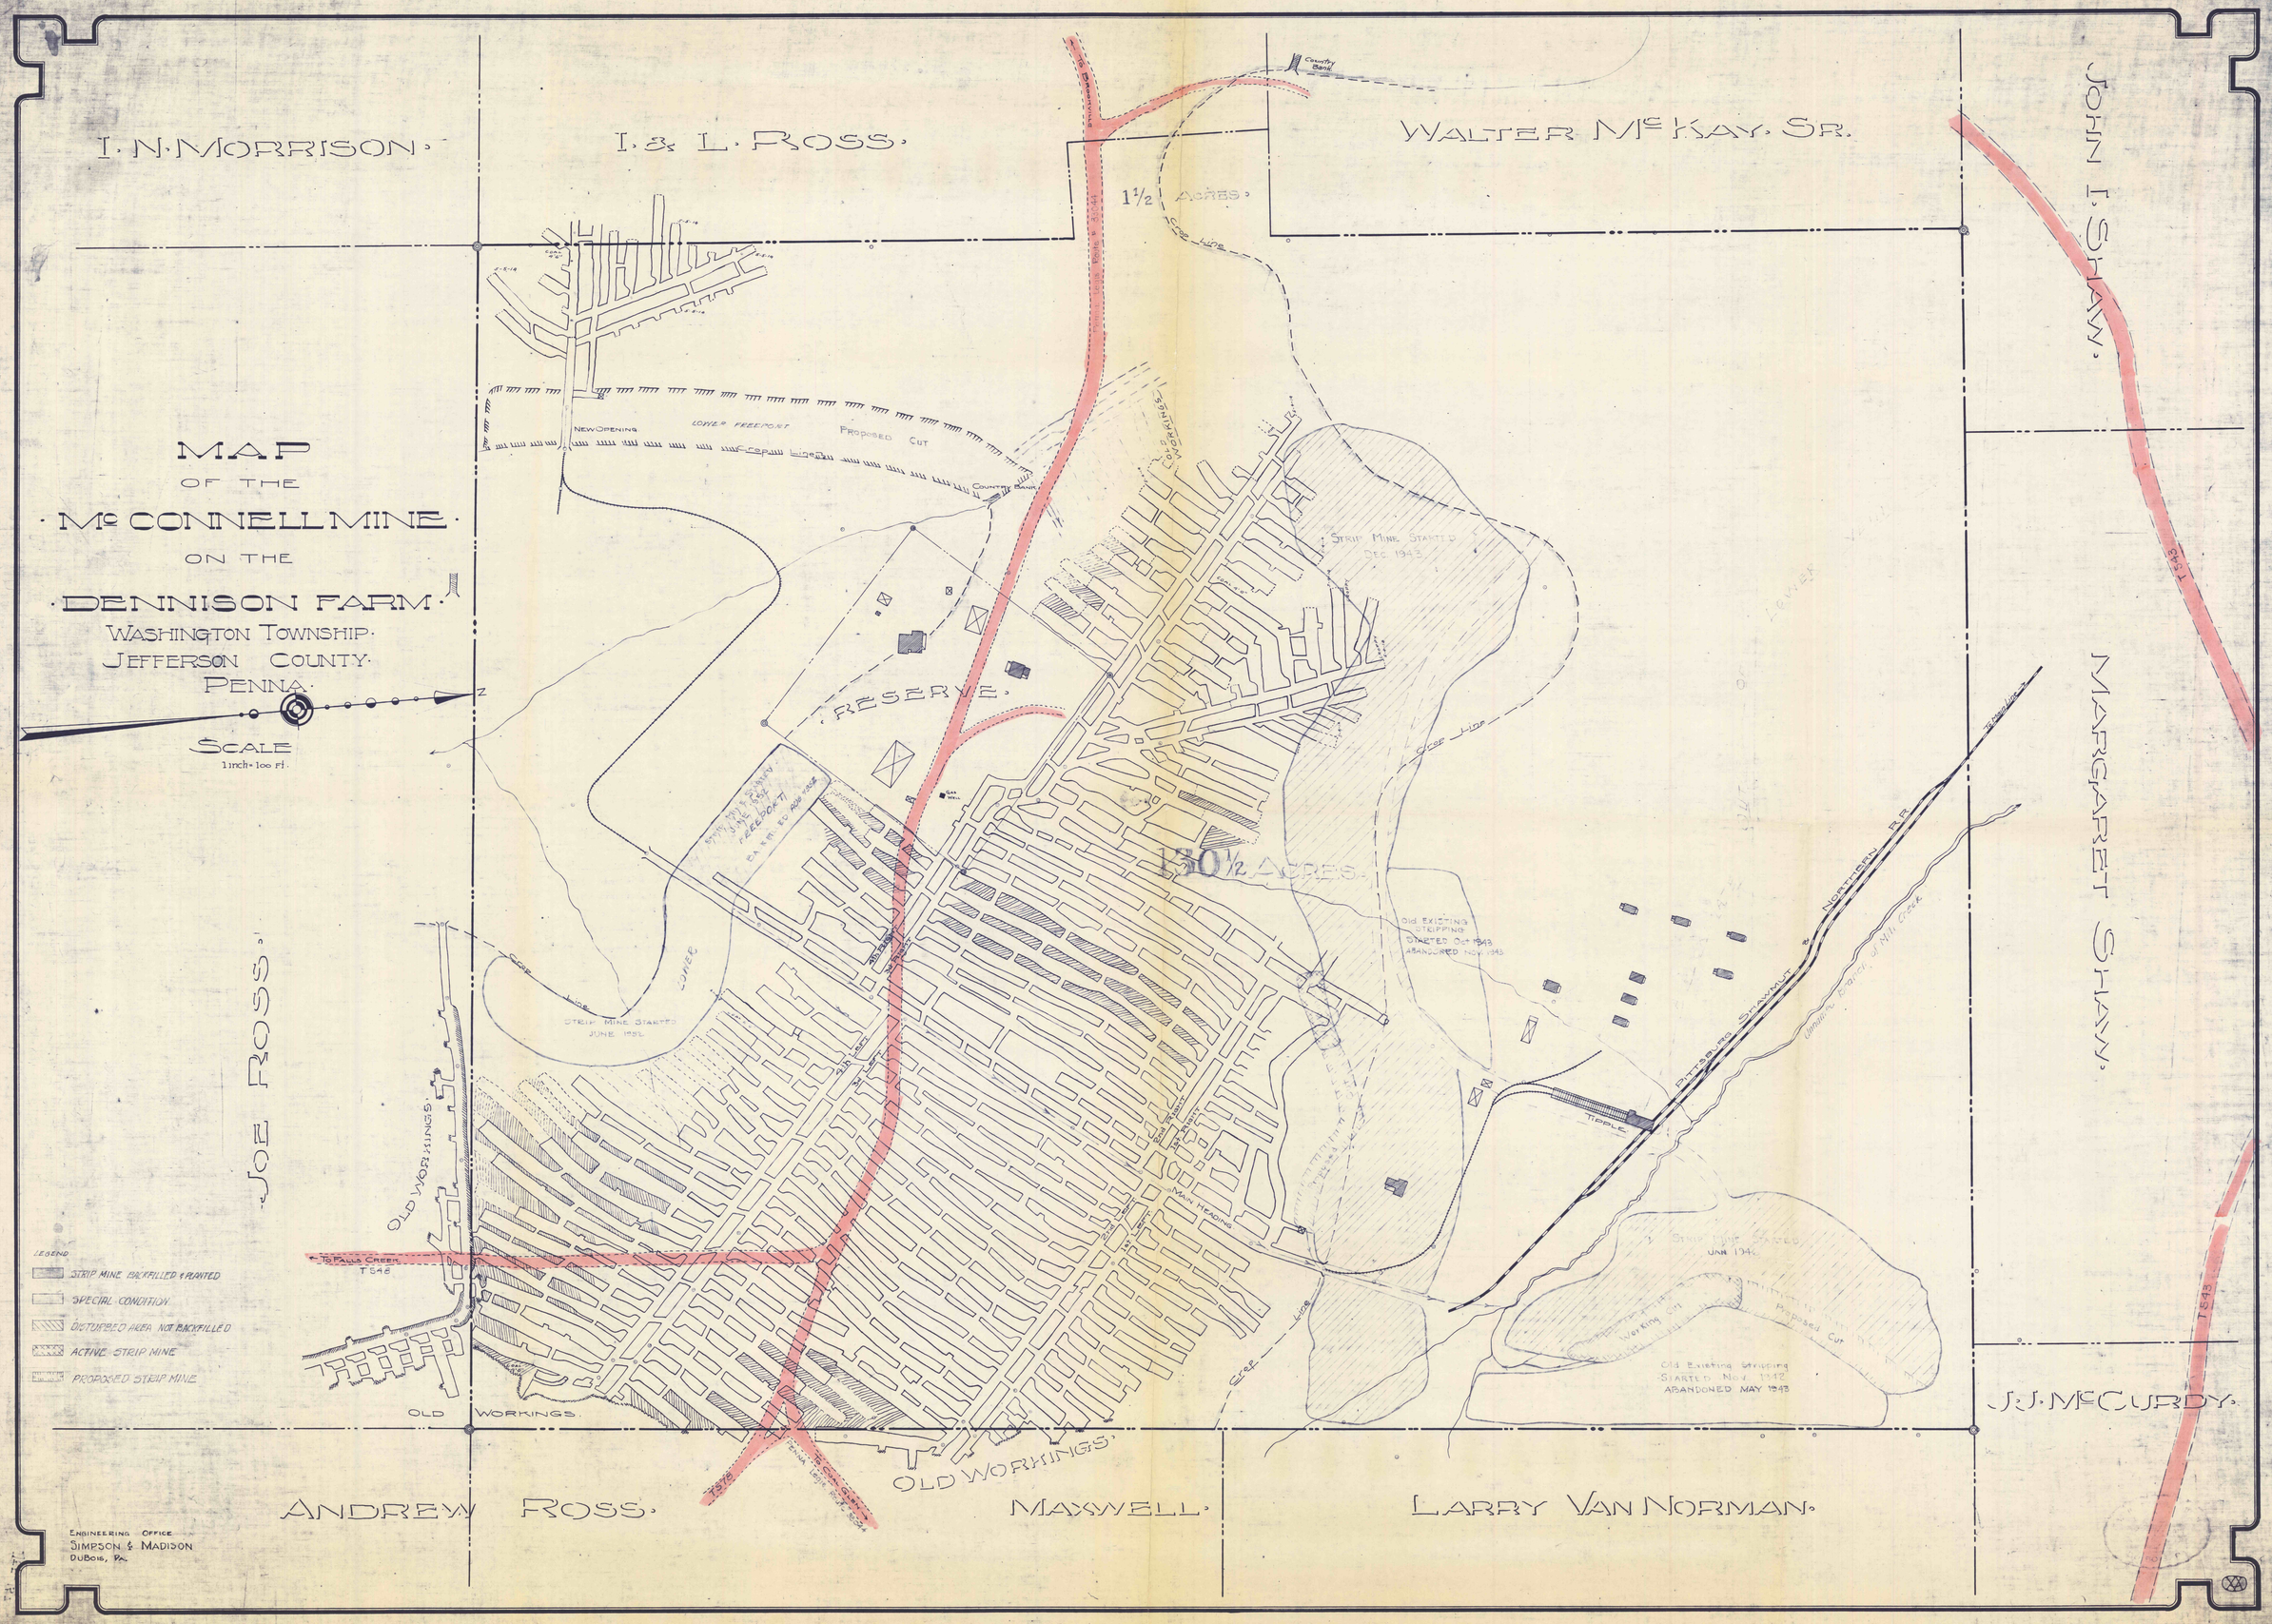

MAP
OF THE
McCONNELL MINE
ON THE
DENNISON FARM
WASHINGTON TOWNSHIP
JEFFERSON COUNTY
PENNA.
SCALE
1 inch = 100 ft.
I. N. MORRISON
I. & L. ROSS
WALTER McKAY SR.
JOHN I. SHAW
MARGARET SHAW
J. J. McCURDY
ANDREW ROSS
MAXWELL
LARRY VAN NORMAN
JOE ROSS
1½ ACRES
130½ ACRES
RESERVE
NEW OPENING
LOWER FREEPORT
PROPOSED CUT
STRIP MINE STARTED DEC 1943
STRIP MINE STARTED JUNE 1952
OLD WORKINGS
OLD WORKINGS
OLD WORKINGS
MAIN HEADING
TIPPLE
PITTSBURG SHAWMUT & NORTHERN R.R.
Old Existing Stripping Started Oct 1943 Abandoned Nov 1943
Old Existing Stripping Started Nov 1942 Abandoned May 1943
Working Cut
Proposed Cut
Crop Line
Country Bank
LEGEND
STRIP MINE BACKFILLED & PLANTED
SPECIAL CONDITION
DISTURBED AREA NOT BACKFILLED
ACTIVE STRIP MINE
PROPOSED STRIP MINE
ENGINEERING OFFICE
SIMPSON & MADISON
DUBOIS, PA.