


CLARA NIEL AND JAMES NIEL HEIRS

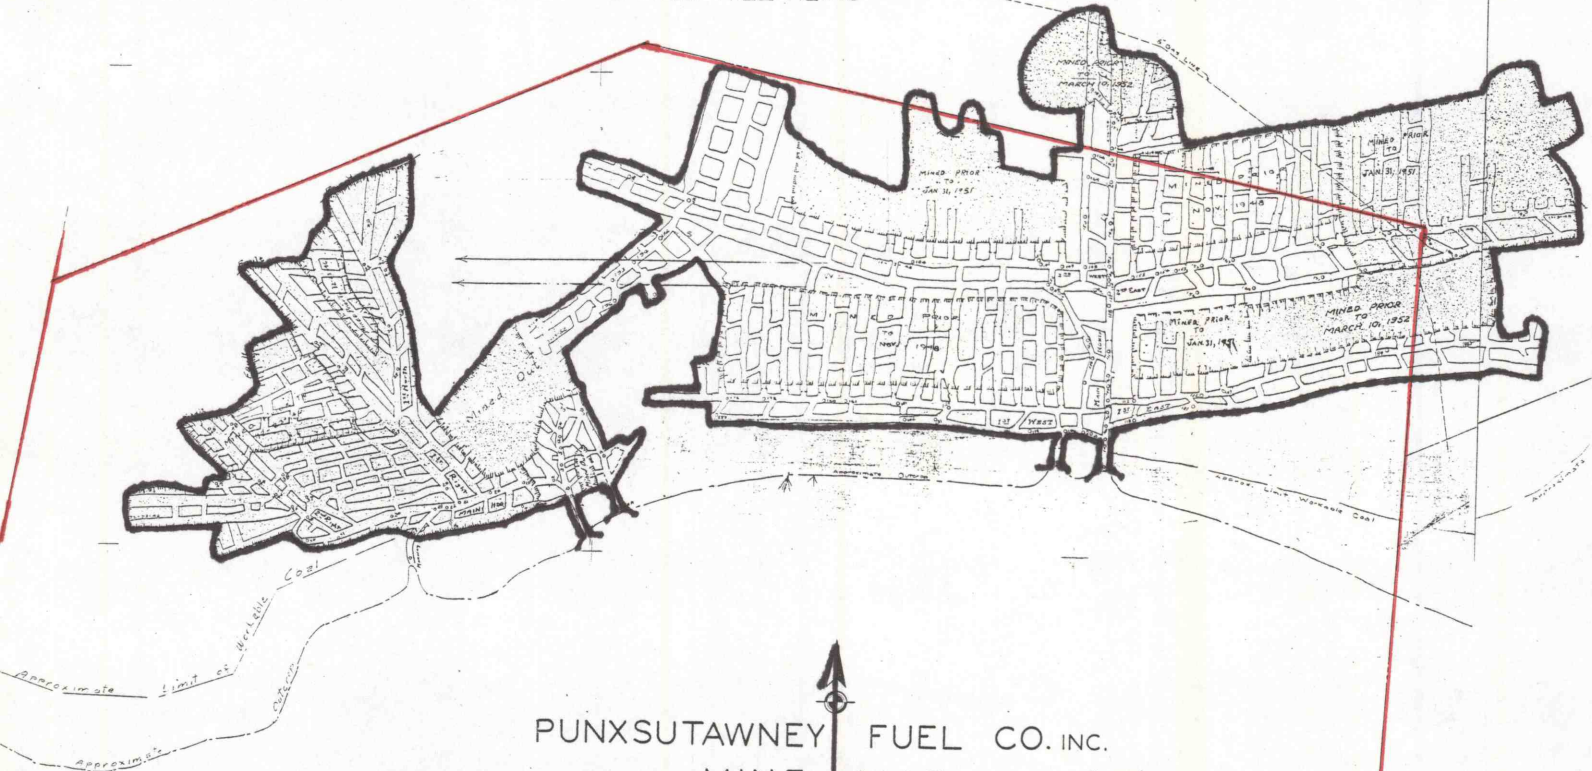

PUNXSUTAWNEY FUEL CO. INC.  
MINE MAP  
NEALE MINE  
PERRY TOWNSHIP, JEFFERSON COUNTY, PA.

