


CLARA NIEL AND JAMES NIEL HEIRS

JOHN, JAMES & CLARA NIEL

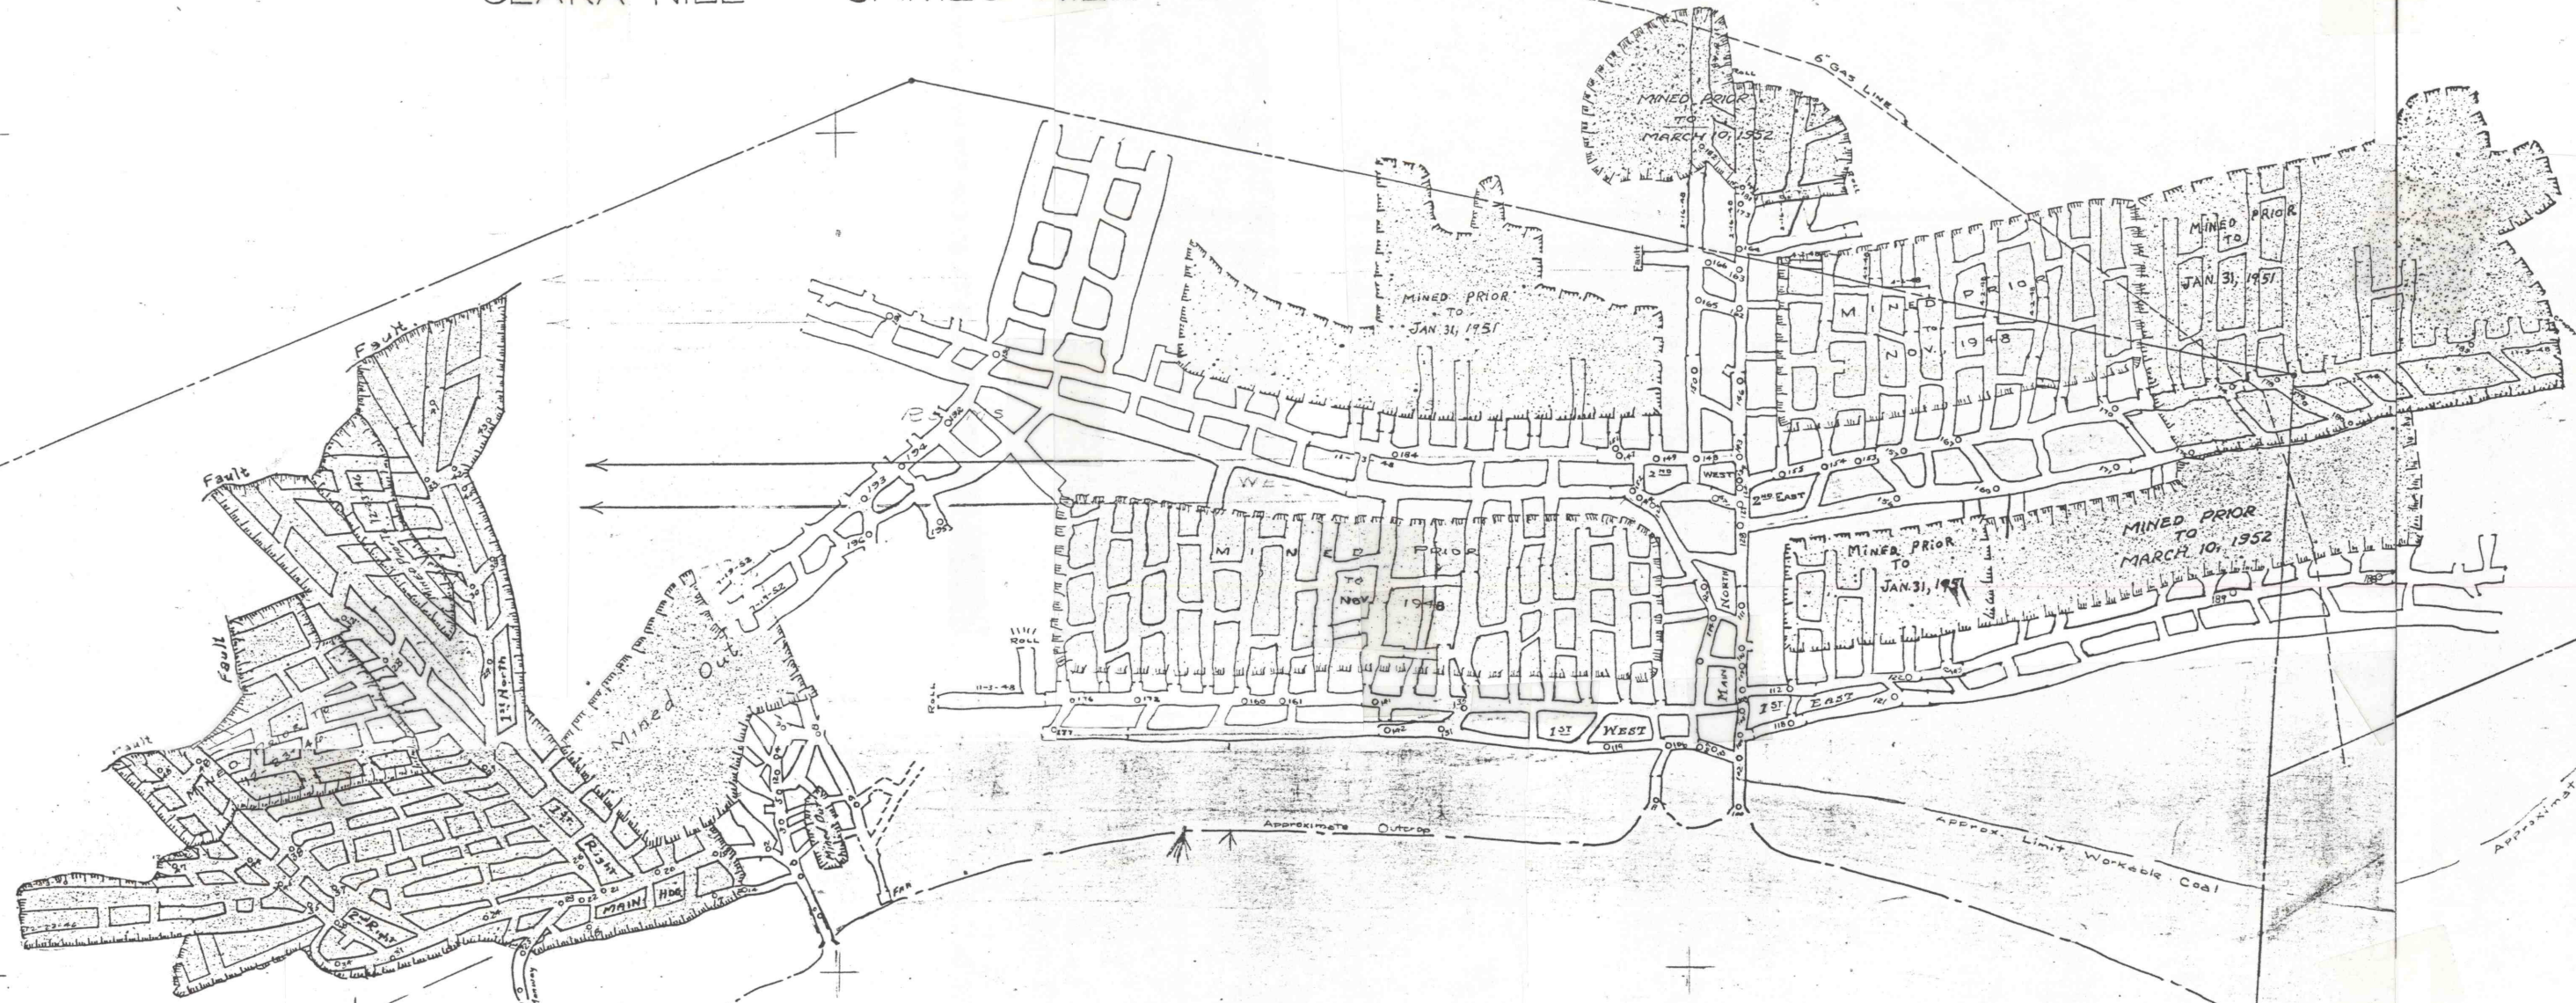

PUNXSUTAWNEY FUEL CO. INC.

MINE MAP

NEALE MINE

PERRY TOWNSHIP, JEFFERSON COUNTY, PA.

1"=200'

