


CLARA NIEL AND JAMES NIEL HEIRS

CLARA NIEL AND JAMES NIEL HEIRS

JOHN, JAMES & CLARA NIEL

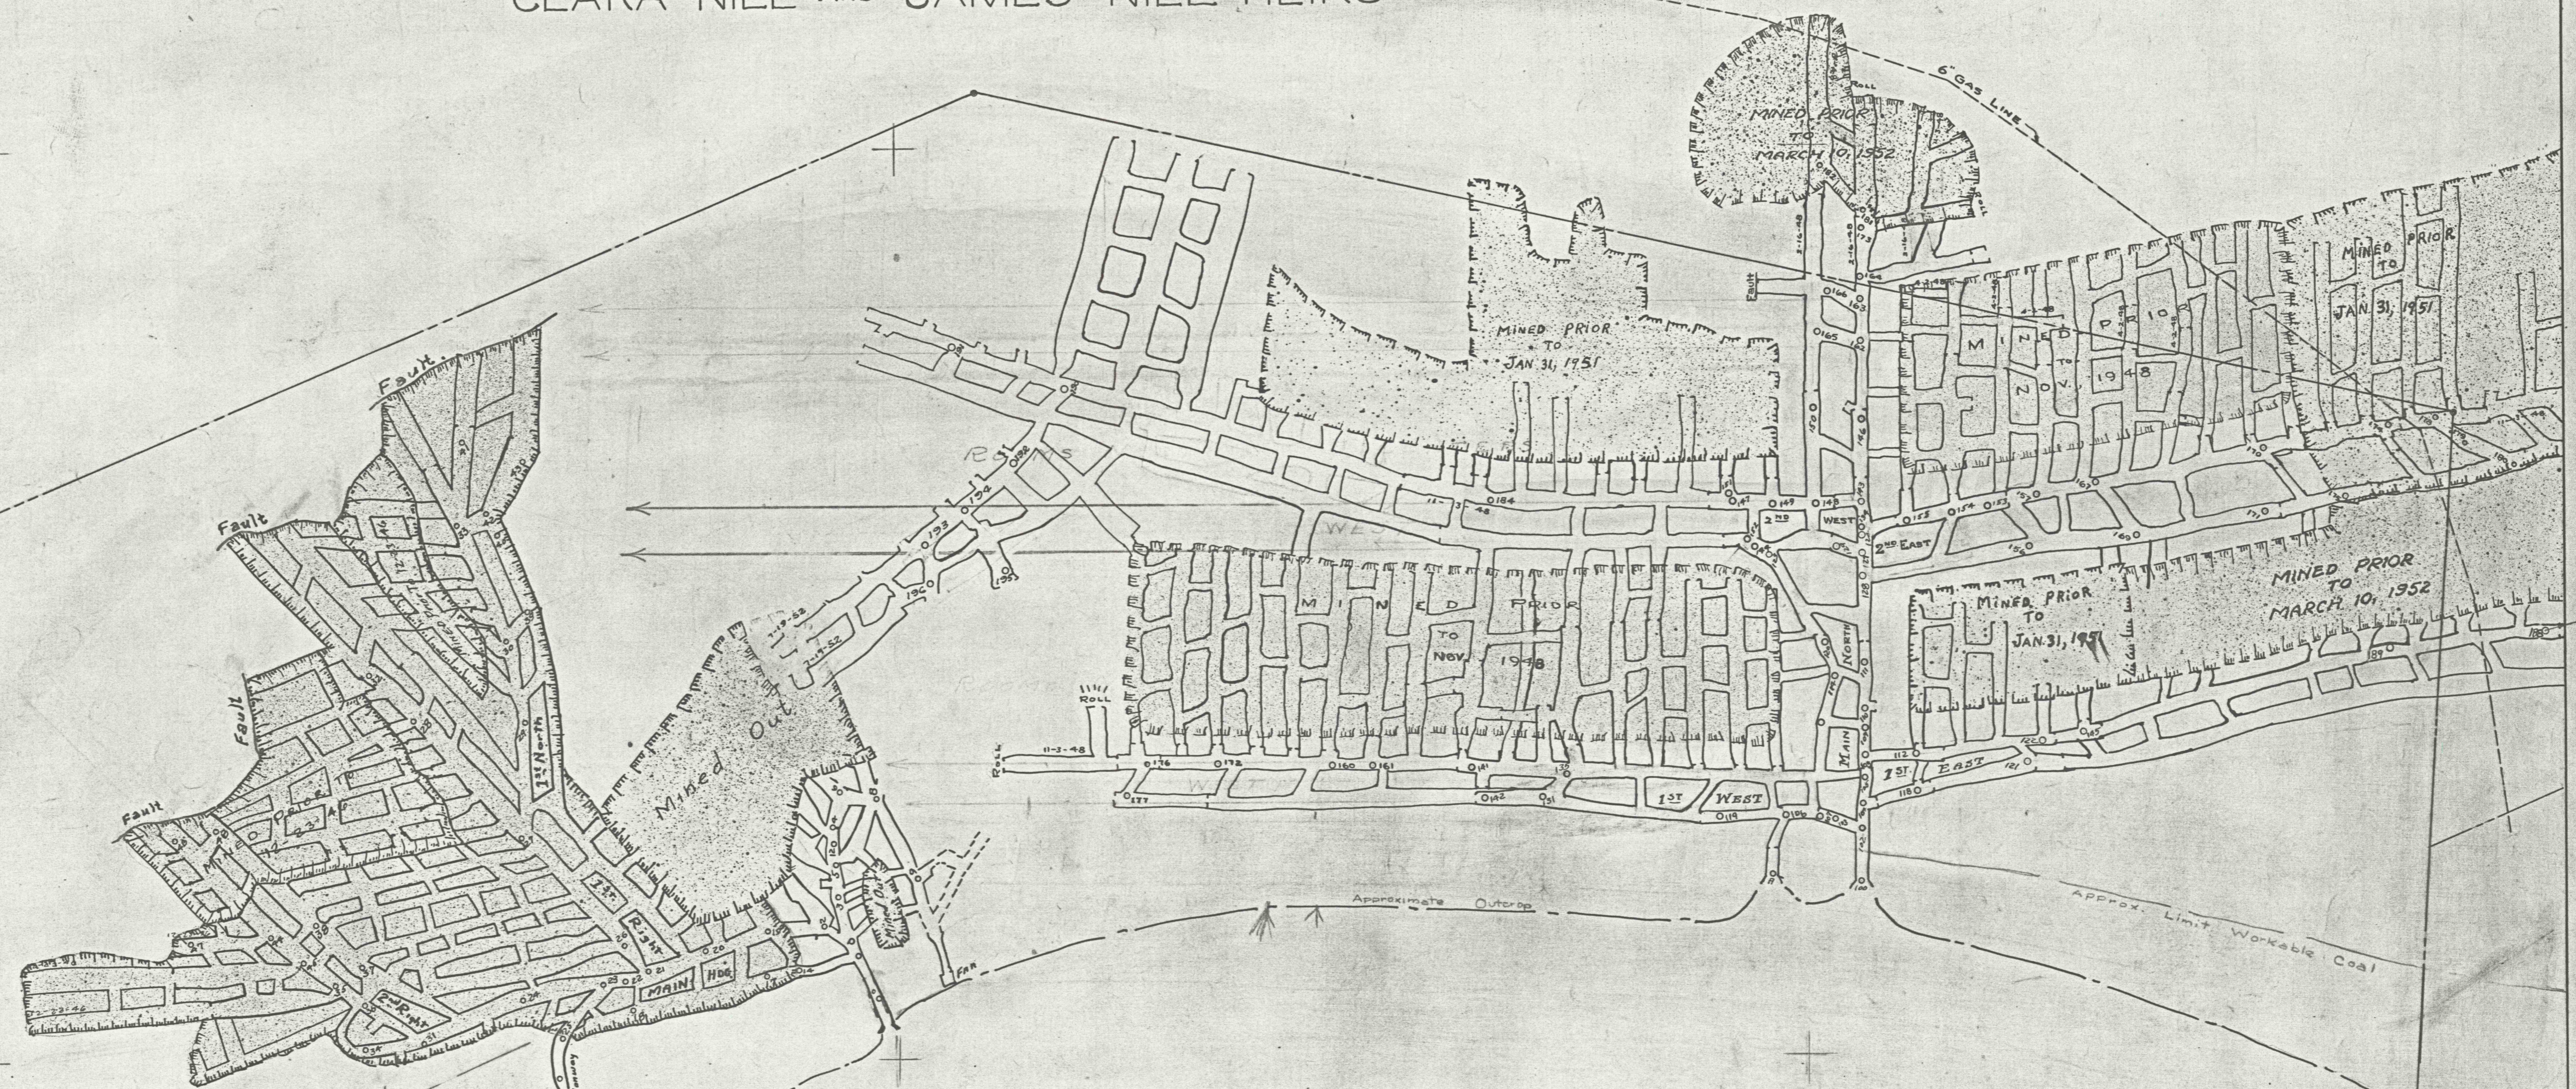

PUNXSUTAWNEY FUEL CO. INC.


MINE MAP

NEALE MINE

PERRY TOWNSHIP, JEFFERSON COUNTY, PA.

SCALE 1" = 100' | SEPT., 1943

WALTER J. ZIMMERMAN
SURVEYOR
PUNXSUTAWNEY, PA.

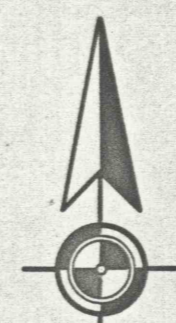

CG-10-10