
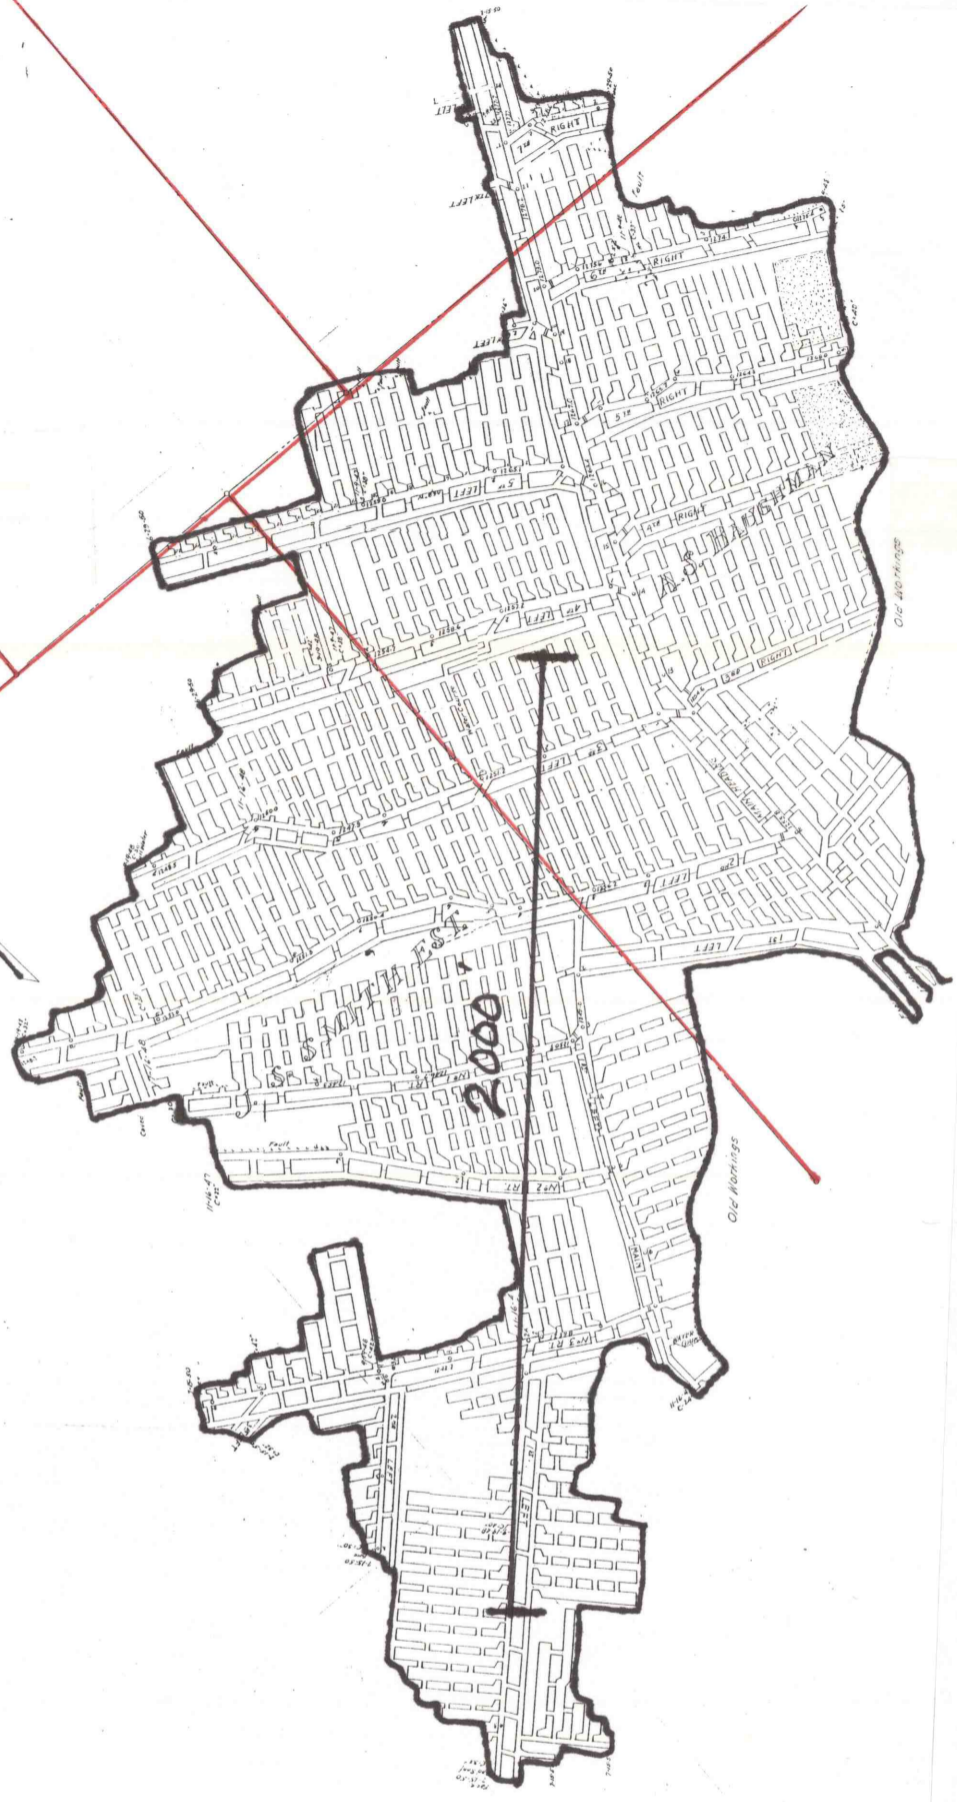


LAUGHMAN

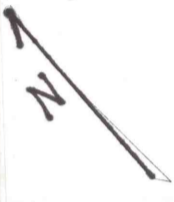

**CREEKSIDE MINING CO.**

Clover Township Jefferson County, Pa.

Scale: 1"=100'

7-15-50 Est.

Jno. C. Kather P.E.