


A. S. BAUGHMAN

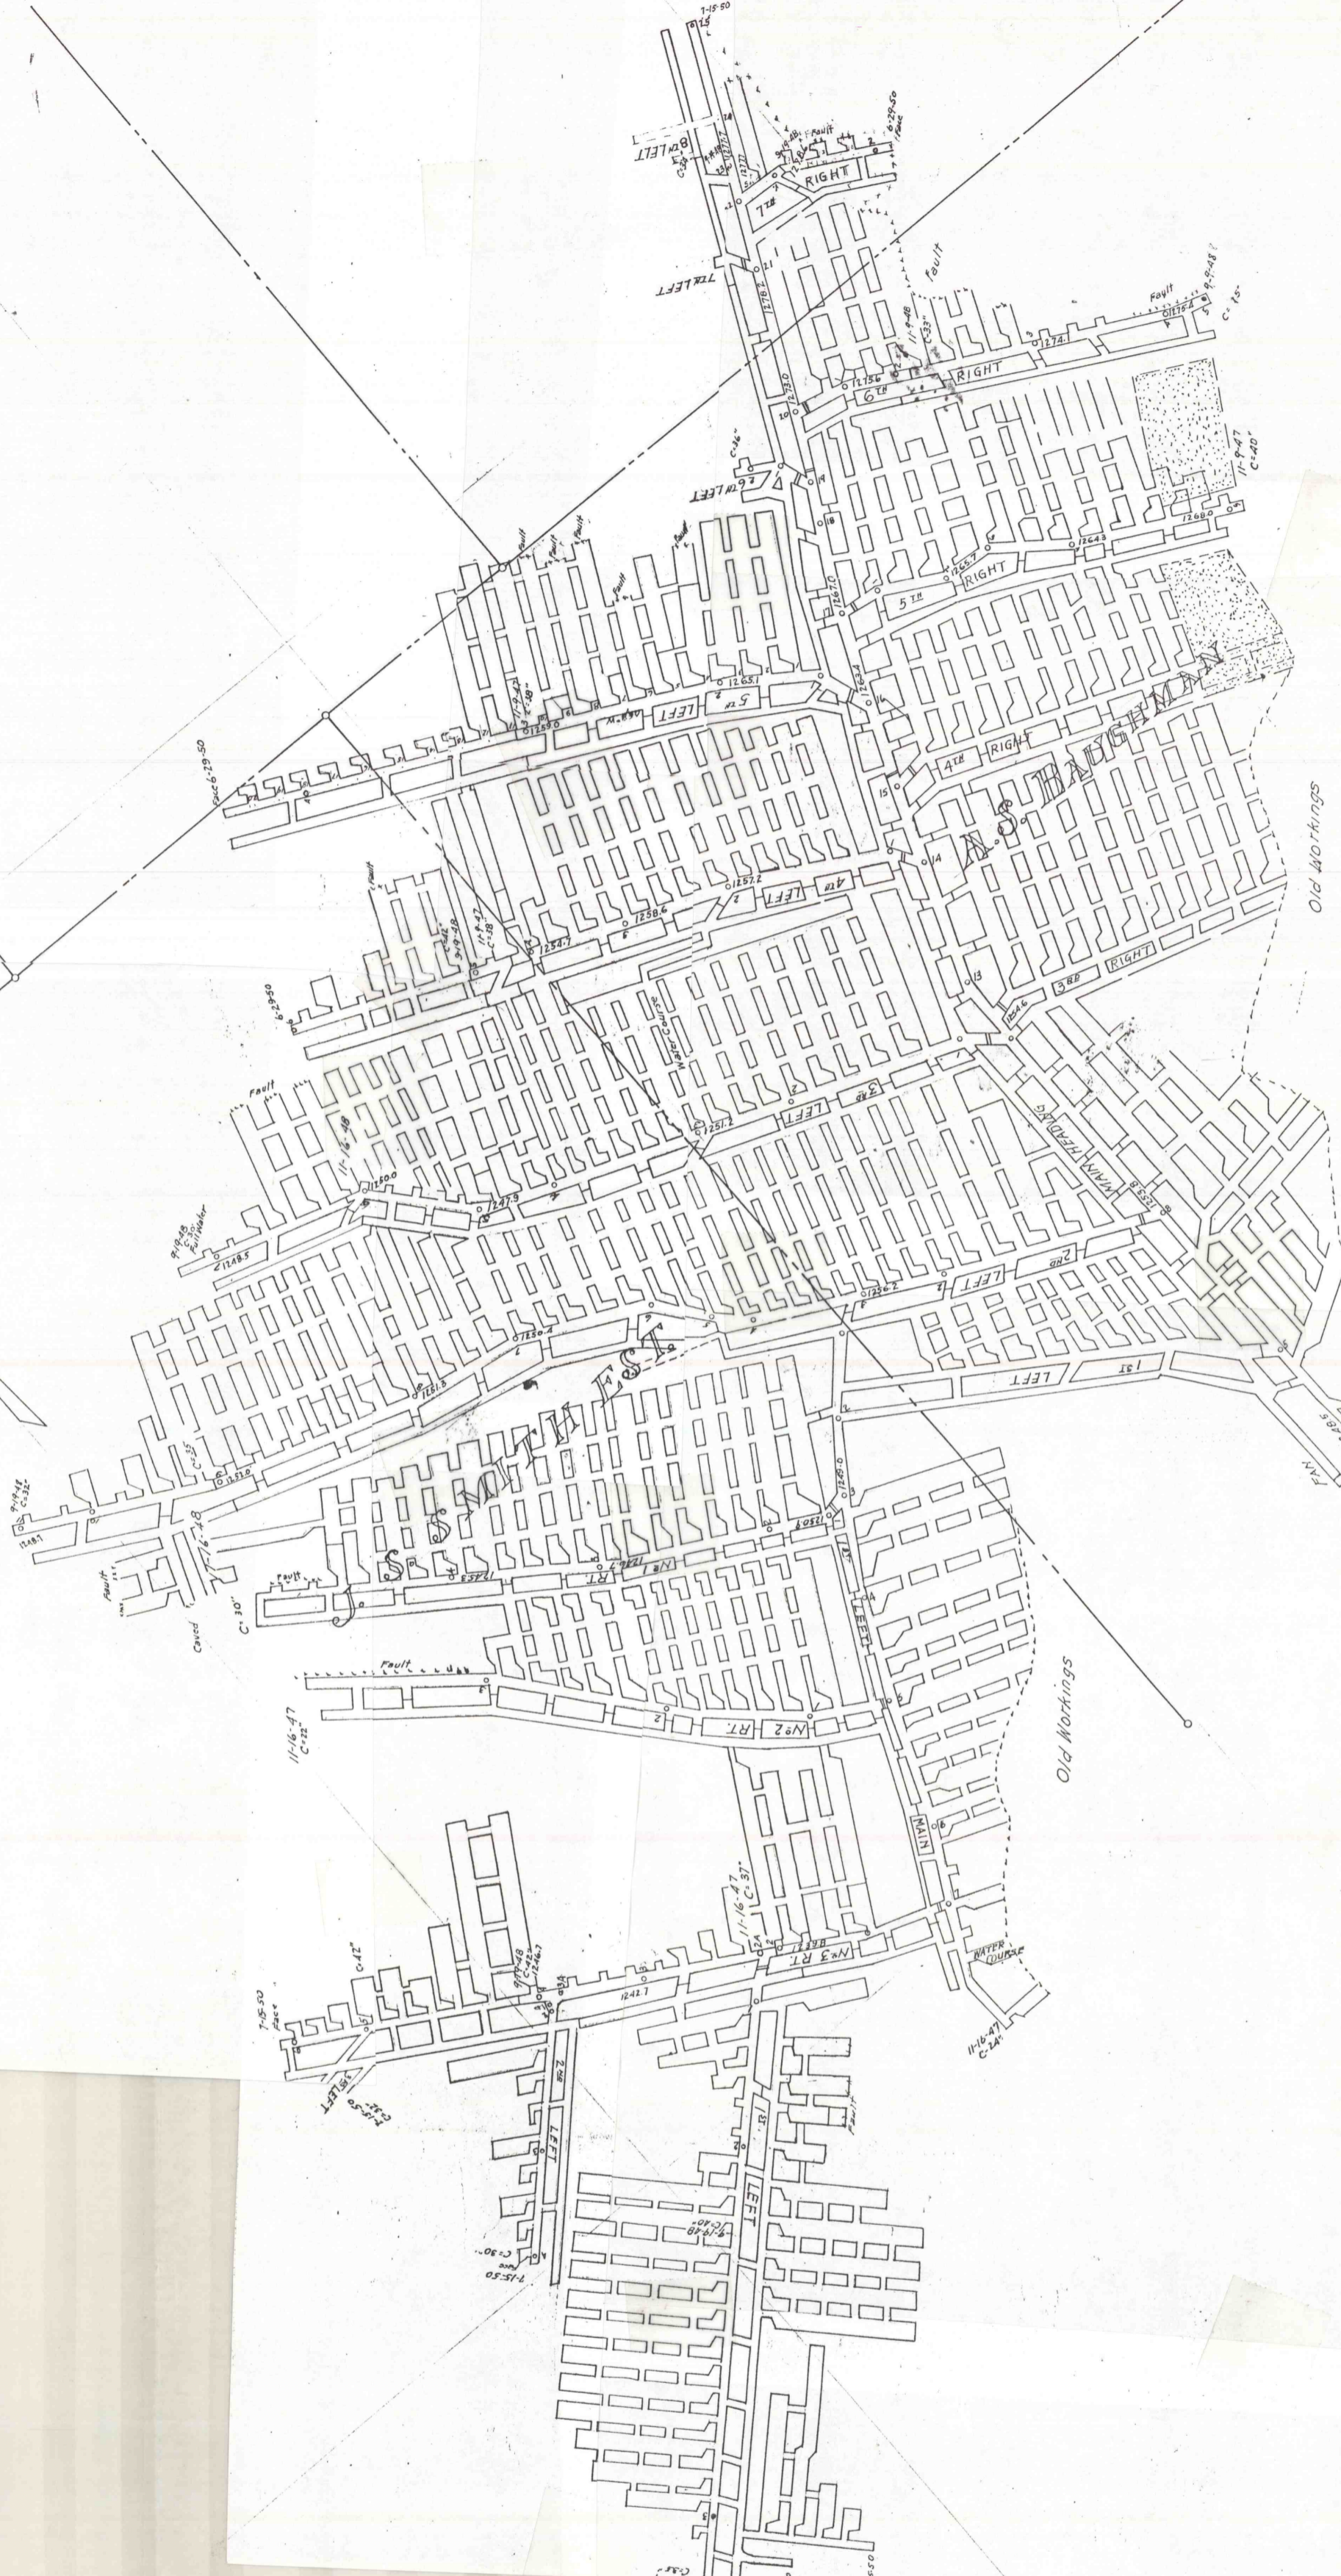

CREEKSIDE MINING CO.
Clover Township Jefferson County, Pa.

Scale: 1"=100'

7-15-50 Est.
Jno. C. Kather P.E.
Phone Fredonia 3065