


1000'

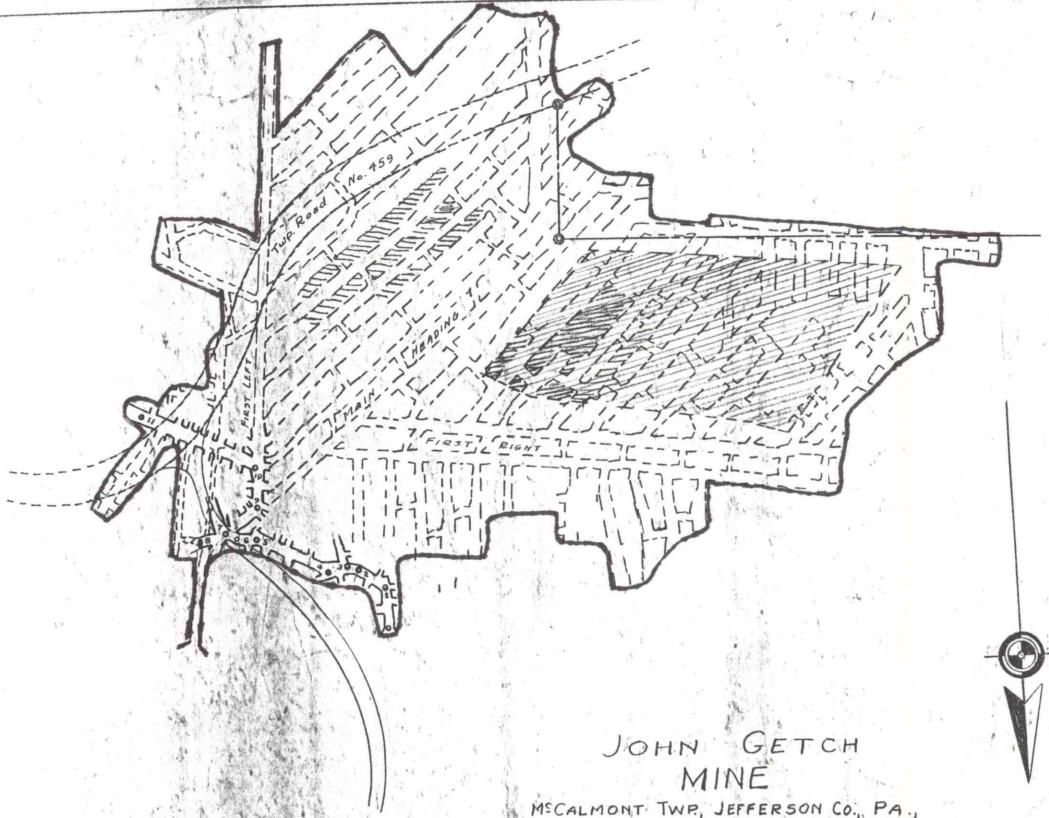

JOHN GETCH
MINE
MERCALMONT TWP, JEFFERSON CO., PA.,
SCALE 1" = 100' AUG., 1946,
Walter J. Zimmerman
Surveyor
Punxsutawney, Pa.

1-A-III