


RECEIVED  
MINE  
SUBSIDENCE REGULATION  
DEC 1 8 1976  
MANROCK

RINGGOLD MINE  
DOVERSPIKE BROS. COAL CO.  
MINING COMPLETED AS SHOWN - 11-30-76

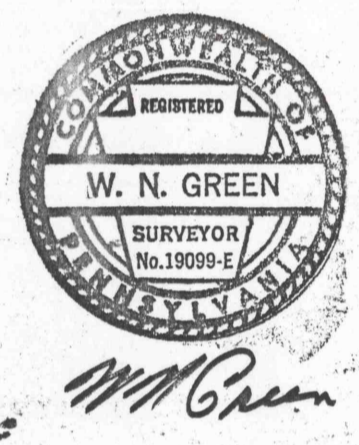


2

NORTH



DOVERSPIKE BROS.

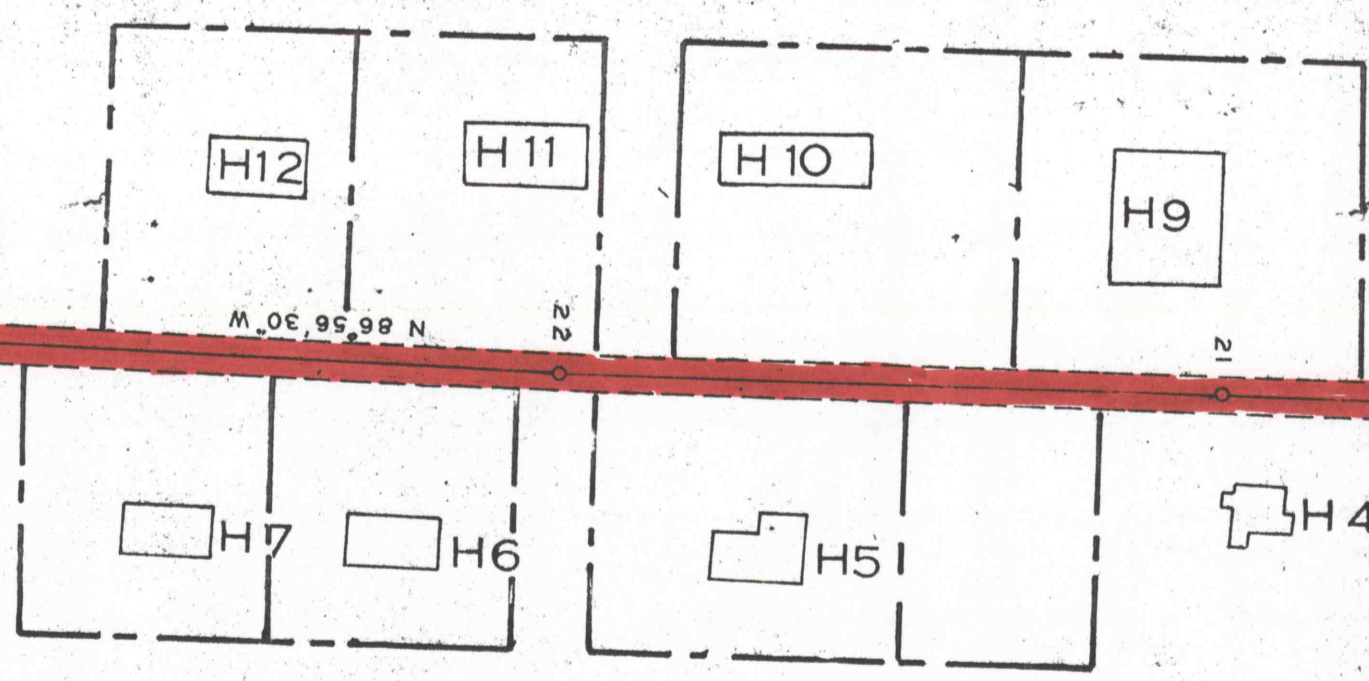

JAMES E. MARTZ

DOVERSPIKE BROS.

J.I. BULLERS