



R. R. YOUNG

JAMES E. MARTZ

DOVERSPIKE BROS., INC.

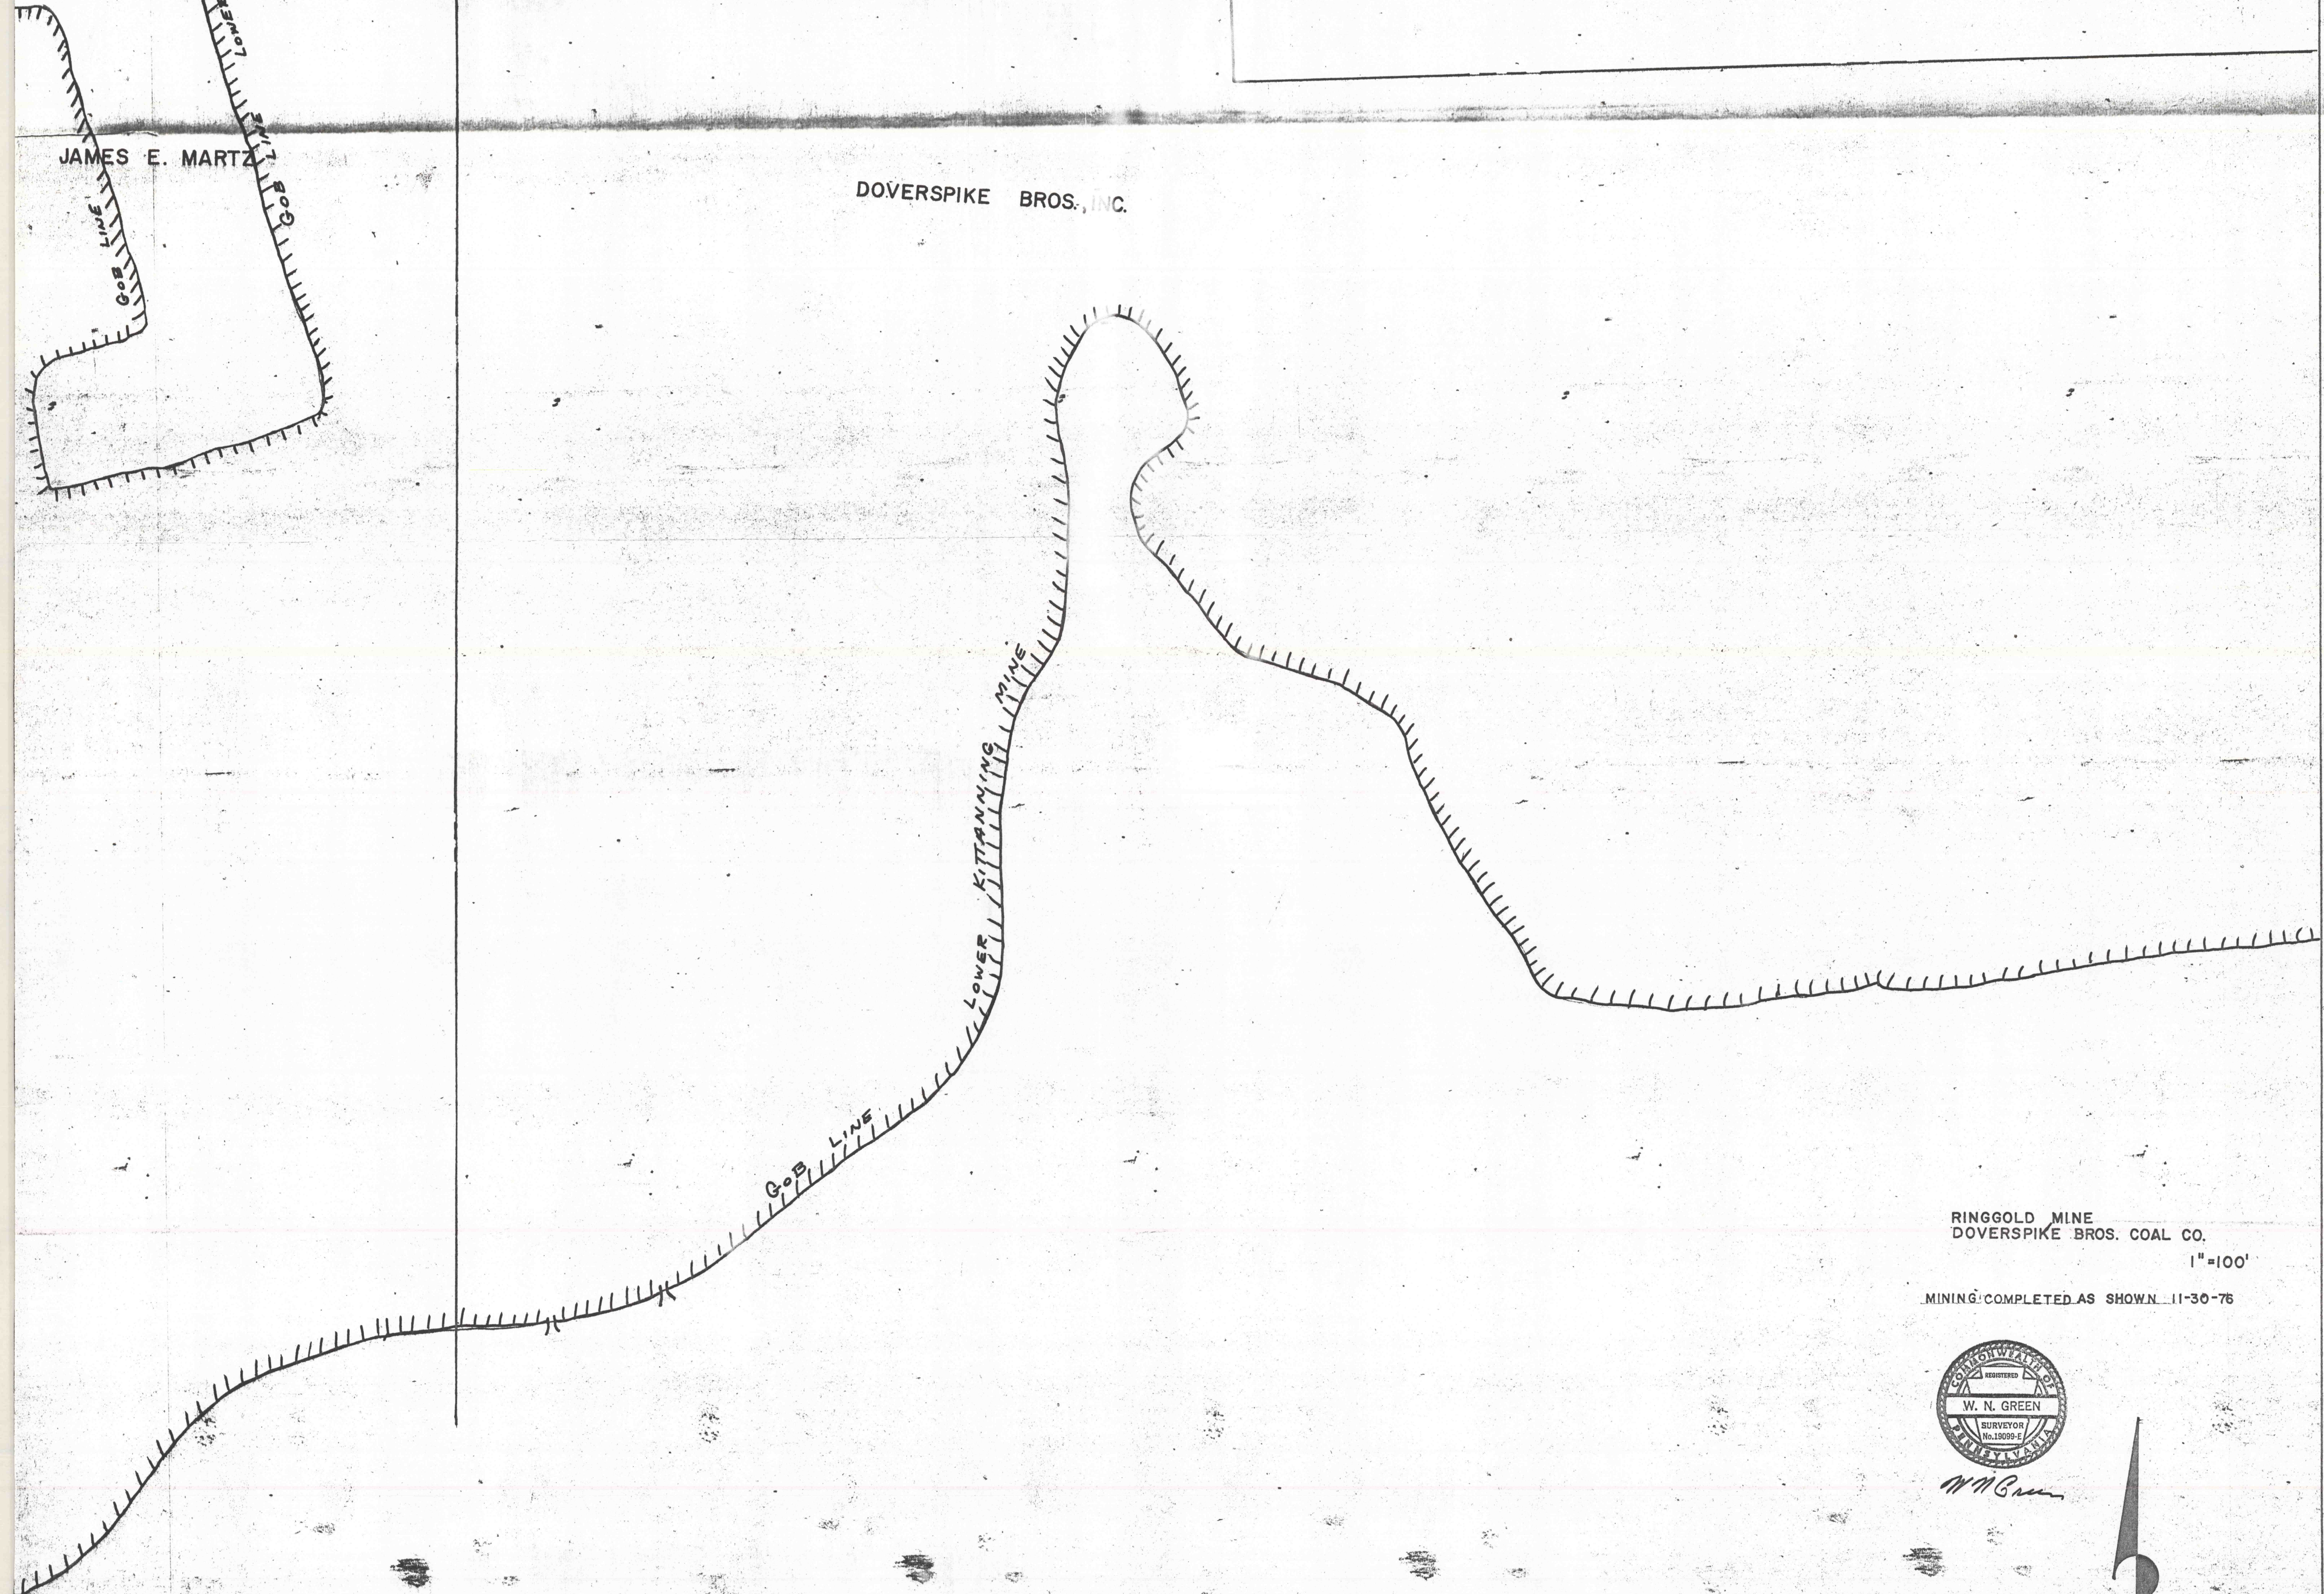

RINGGOLD MINE
DOVERSPIKE BROS. COAL CO.
1"=100'
MINING COMPLETED AS SHOWN 11-30-76

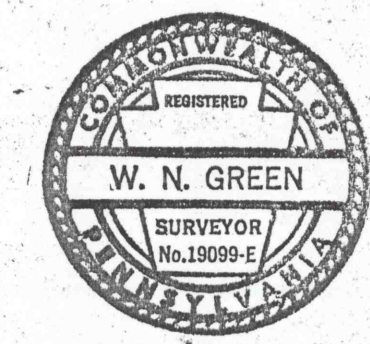

W. N. Green



RECEIVED
DIVISION OF
SUBSIDENCE REGULATION
DEC 1 1976
HARRISBURG
PENNSYLVANIA