


DOVERSPIKE BROS. INC.

R. R. YOUNG

JAMES E. MARTZ

R. R. YOUNG

RINGGOLD MINE
DOVERSPIKE BROS. COAL CO.
1"=100'
MINING COMPLETED AS SHOWN 11-30-76

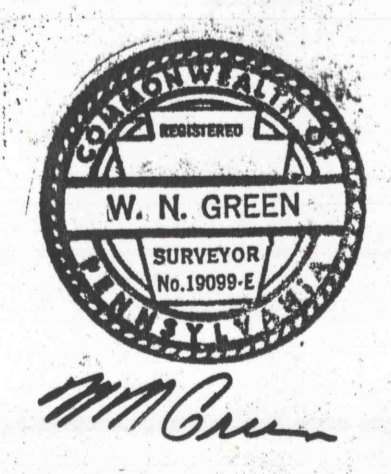

SUBSIDY
DEC 1 1976
McMURRAY
PENNSYLVANIA