

MSHA I.D. No. 36-06583 CMAP No. 33841303




Doverspike Bros. Coal Co.  
R.D. #4, Box 271, Punxsutawney, PA 15767  
Porter & Perry Twp., Jefferson County

**DORA #6 MINE**


SCALE: 1" = 200' SHEET 7 of 24

**Final Mine Map**

- |  |   |  |  |
|--|---|--|--|
| <ul style="list-style-type: none"> <li>— PERMIT AREA</li> <li>- - - PROPERTY LINES</li> <li>① PROPERTY OWNERS</li> <li>② CONT. PROPERTY OWNERS</li> <li>▲ PRE-66 DWELLINGS</li> <li>■ DWELLINGS, STRUCTURES</li> <li>Ⓜ PROT. ACT 54 STRUCTURES</li> <li>-LK-1480- L.K. COAL CONTOURS</li> <li>▨ L.K. COAL OUTCROP</li> </ul> | <ul style="list-style-type: none"> <li>..... GAS LINE</li> <li>⊙ GAS WELL</li> <li>-T- TELE./ELEC. LINES</li> <li>● WATER WELL</li> <li>○ SPRING</li> <li>⊙ DRILL HOLE</li> <li>▨ IMPOUNDMENT</li> <li>◇ CEMETERY</li> <li>↔ MINE OPENINGS, NOT SEALED</li> </ul> | <ul style="list-style-type: none"> <li>↔ MINE OPENINGS, SEALED</li> <li>..... STREAMS</li> <li>▲<sub>12</sub> SURVEY STATION</li> <li>▨ SUPPORT AREA (No Second Mining)</li> <li>▨ L.F. DEEP MINE</li> <li>▨ ZONE OF POTENTIAL INFLUENCE</li> <li>⊙ GAS WELL BARRIER (No Mining Within Barrier Unless Approved)</li> <li>XXXXXXXXXX</li> </ul> | <ul style="list-style-type: none"> <li>↔ INTAKE AIR</li> <li>↔ RETURN AIR</li> <li>— BELT LINE</li> <li>— STOPPING</li> <li>— STOPPING W/ DOOR</li> <li>⊙ CHECK CURTAIN</li> <li>— REGULATOR</li> <li>— DOUBLE DOORS</li> <li>— RUN-THROUGH CHECK</li> <li>⊗ OVERCAST</li> </ul> |
|--|---|--|--|

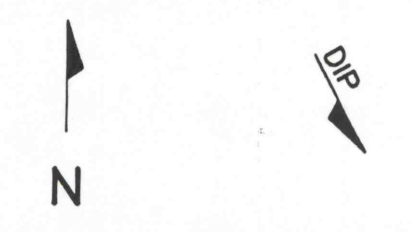

SURVEY IS CLOSED LOOP; ACCURACY IS 1:10000  
INDIVIDUALS RESPONSIBLE FOR INFORMATION:  
CHARLES ISHMAN, ENGINEER & CHUCK MARTZ, SUPERINTENDENT  
MAP FULFILLS REQUIREMENTS OF 75.372 & 75.1200  
NO ADJACENT MINE WORKINGS WITHIN 1000 FEET  
NO MINE WORKINGS BELOW MINE PROPERTY

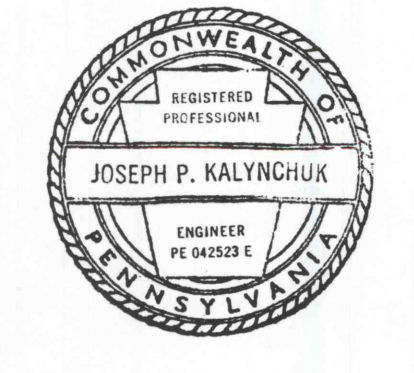

SIGNATURE *Joseph P. Kalynduk*  
11/19

**FINAL MINE MAP**