

MSHA I.D. No. 36-06583 CMAP No. 33841303

Stanford

Doverspike Bros. Coal Co.
 R.D. #4, Box 271, Punxsutawney, PA 15767
 Porter & Perry Twp., Jefferson County

DORA #6 MINE

SCALE: 1" = 200' SHEET 8 of 24

Final Mine Map

- | | | | |
|--|---|---|--|
| <ul style="list-style-type: none"> — PERMIT AREA - - - PROPERTY LINES ① PROPERTY OWNERS ② CONT. PROPERTY OWNERS ■ PRE-66 DWELLINGS ■ DWELLINGS, STRUCTURES Ⓐ PROT. ACT 54 STRUCTURES -LX-1480- L.K. COAL CONTOURS ▨ L.K. COAL OUTCROP | <ul style="list-style-type: none"> GAS LINE ⊙ GAS WELL -T- TELE./ELEC. LINES ● WATER WELL ○ SPRING ⊙ DRILL HOLE ▨ IMPOUNDMENT ◇ CEMETERY — MINE OPENINGS, NOT SEALED | <ul style="list-style-type: none"> ◀ MINE OPENINGS, SEALED — STREAMS ▲₁₂ SURVEY STATION ▨ SUPPORT AREA(No Second Mining) ▨ L.F. DEEP MINE ▨ ZONE OF POTENTIAL INFLUENCE ● GAS WELL BARRIER (No Mining Within Barrier Unless Approved) XXXXXXXXXX | <ul style="list-style-type: none"> → INTAKE AIR → RETURN AIR — BELT LINE — STOPPING — STOPPING W/ DOOR — CHECK CURTAIN — REGULATOR — DOUBLE DOORS — RUN-THROUGH CHECK ⊗ OVERCAST |
|--|---|---|--|

N

FINAL MINE MAP


SURVEY IS CLOSED LOOP; ACCURACY IS 1:10000

INDIVIDUALS RESPONSIBLE FOR INFORMATION:
 CHARLES ISHMAN, ENGINEER & CHUCK MARTZ, SUPERINTENDENT

MAP FULFILLS REQUIREMENTS OF 75.372 & 75.1200

NO ADJACENT MINE WORKINGS WITHIN 1000 FEET

NO MINE WORKINGS BELOW MINE PROPERTY

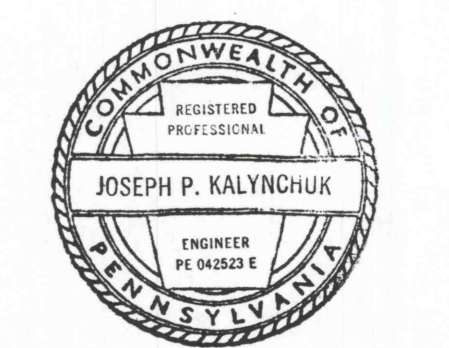

SIGNATURE *Joseph P. Kalyanchuk*

4-14-99