

DH-13
-1700.0
-1318.1

SM85-009
S-1700.0
LK-1349.5

BOREHOLE "F"
diam = 1683
diam = 1310
5/8" DIAMETER

A16
S-1658
LK-1327.5

SM82-008
S-1337.8
LK-1340.5

SM84-010
S-1340.0
LK-1299.6

SM84-001
S-1327.0
LK-1278.9

SM84-002
S-1320.0
LK-1280.8

SM84-009
S-1318.0
LK-1271.1

SM84-008
S-1314.0
LK-1271.3

A-15
S-1640.0
LK-1412.4

MSHA I.D. No. 36-08583 CMAP No. 33841303



Doverspike Bros. Coal Co.
R.D. #4, Box 271, Punxsutawney, PA 15767
Porter & Perry Twp., Jefferson County

DORA #6 MINE

SCALE: 1" = 200' SHEET 10 of 24

Final Mine Map

- PERMIT AREA
- PROPERTY LINES
- PROPERTY OWNERS
- CONT. PROPERTY OWNERS
- PRE-66 DWELLINGS
- DWELLINGS, STRUCTURES
- PROT. ACT 54 STRUCTURES
- LK-1400- L.K. COAL CONTOUR
- L.K. COAL OUTCROP


- GAS LINE
- GAS WELL
- TELE./ELEC. LINES
- WATER WELL
- SPRING
- DRILL HOLE
- IMPOUNDMENT
- CULMILERY
- MINE OPENINGS, NOT SEALED

- MINE OPENINGS, SEALED
- STREAMS
- SURVEY STATION
- SUPPORT AREA (No Second Mining)
- L.F. DEEP MINE
- ZONE OF POTENTIAL INFLUENCE
- GAS WELL TAPPOINT (No Mining Within 1000 Feet Unless Approved)

- INTAKE AIR
- RETURN AIR
- BELT LINE
- STOPPING
- STOPPING W/ DOOR
- CHECK CURTAIN
- REGULATOR
- DOUBLE DOORS
- RUN-THROUGH CHECK



SURVEY IS CLOSED LOOP; ACCURACY IS 1:10000
INDIVIDUALS RESPONSIBLE FOR INFORMATION:
CHARLES ISHMAN, ENGINEER & CHUCK MARTZ, SUPERINTENDENT
MAP FULFILLS REQUIREMENTS OF 75.372 & 75.1200
NO ADJACENT MINE WORKINGS WITHIN 1000 FEET
NO MINE WORKINGS BELOW MINE PROPERTY

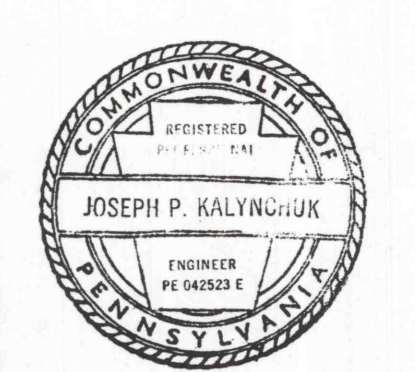

FINAL MINE MAP

Joseph P. Kalynduk