


MSHA I.D. No. 36-06583 CMAP No. 33841303



Doverspike Bros. Coal Co.
 R.D. #4, Box 271, Punxsutawney, PA 15767
 Porter & Perry Twp., Jefferson County

DORA #6 MINE

SCALE: 1" = 200' SHEET 14 of 24

Final Mine Map

- | | | | |
|-------------------------------|-------------------------|---|---------------------|
| — PERMIT AREA | GAS LINE | — MINE OPENINGS, SEALED | → INTAKE AIR |
| --- PROPERTY LINES | ⊙ GAS WELL | --- STREAMS | ← RETURN AIR |
| ① PROPERTY OWNERS | — T — TELE./ELEC. LINES | ▲ SURVEY STATION | == BELT LINE |
| ② CONT. PROPERTY OWNERS | ● WATER WELL | ▨ SUPPORT AREA (No Second Mining) | — STOPPING |
| ▲ PRE-66 DWELLINGS | ○ SPRING | ▩ L.F. DEEP MINE | — STOPPING W/ DOOR |
| ■ DWELLINGS, STRUCTURES | ⊙ DRILL HOLE | ▨ ZONE OF POTENTIAL INFLUENCE | ⊖ CHECK CURTAIN |
| ⊙ PROT. ACT 54 STRUCTURES | ▨ IMPOUNDMENT | ● GAS WELL BARRIER (No Mining Within Barrier Unless Approved) | ⊖ REGULATOR |
| ⊖ LK=1480= L.K. COAL CONTOURS | ⊖ CEMETERY | ⊖ MINE OPENINGS, NOT SEALED | ⊖ DOUBLE DOORS |
| ▨ L.K. COAL OUTCROP | | | ⊖ RUN-THROUGH CHECK |
| | | | ⊖ OVERCAST |


N

E

SURVEY IS CLOSED LOOP; ACCURACY IS 1:10000
 INDIVIDUALS RESPONSIBLE FOR INFORMATION:
 CHARLES ISHMAN, ENGINEER & CHUCK MARTZ, SUPERINTENDENT
 MAP FULFILLS REQUIREMENTS OF 75.372 & 75.1200
 NO ADJACENT MINE WORKINGS WITHIN 1000 FEET
 NO MINE WORKINGS BELOW MINE PROPERTY

FINAL MINE MAP

SIGNATURE *Joseph P. Kalyndjuk*

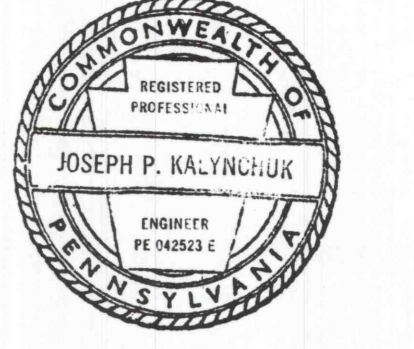

 ENGINEER
