

MSHA I.D. No. 36-06583 CMAP No. 33841303

Stanford

Doverspike Bros. Coal Co.
 R.D. #4, Box 271, Punxsutawney, PA 15767
 Porter & Perry Twp., Jefferson County

DORA #6 MINE

SCALE: 1" = 200' SHEET 15 of 24

<p>— PERMIT AREA</p> <p>- - - PROPERTY LINES</p> <p>① PROPERTY OWNERS</p> <p>② CONT. PROPERTY OWNERS</p> <p>▲ PRE-66 DWELLINGS</p> <p>■ DWELLINGS, STRUCTURES</p> <p>Ⓜ PROT. ACT 64 STRUCTURES</p> <p>-LK-1480- L.K. COAL CONTOURS</p>	<p>..... GAS LINE</p> <p>⊙ GAS WELL</p> <p>-T L- TELE./ELEC. LINES</p> <p>● WATER WELL</p> <p>○ SPRING</p> <p>⊙ DRILL HOLE</p> <p>▨ IMPOUNDMENT</p> <p>◇ CEMETERY</p> <p>— MINE OPENINGS NOT SEALED</p>	<p>◀ MINE OPENINGS, SEALED</p> <p>— STREAMS</p> <p>⊙ SURVEY STATION</p> <p>▨ SUPPORT AREA (No Second Mining)</p> <p>▨ L.F. DEEP MINE</p> <p>▨ ZONE OF POTENTIAL INFLUENCE</p> <p>⊙ GAS WELL HAZARDOUS (No Mining Within 1000' Unless Approved)</p>	<p>→ INTAKE AIR</p> <p>← RETURN AIR</p> <p>— BELT LINE</p> <p>▨ STOPPING</p> <p>▨ STOPPING W/ DOOR</p> <p>⊙ CHECK CURTAIN</p> <p>▨ REGULATOR</p> <p>▨ DOUBLE DOORS</p> <p>⊙ RUN-THROUGH CHECK</p> <p>⊗ OVERCAST</p>
--	---	--	---


SURVEY IS CLOSED LOOP; ACCURACY IS 1:10000

INDIVIDUALS RESPONSIBLE FOR INFORMATION:
 CHARLES ISHMAN, ENGINEER & CHUCK MARTZ, SUPERINTENDENT

MAP FULFILLS REQUIREMENTS OF 75.372 & 75.1200

NO ADJACENT MINE WORKINGS WITHIN 1000 FEET

NO MINE WORKINGS BELOW MINE PROPERTY

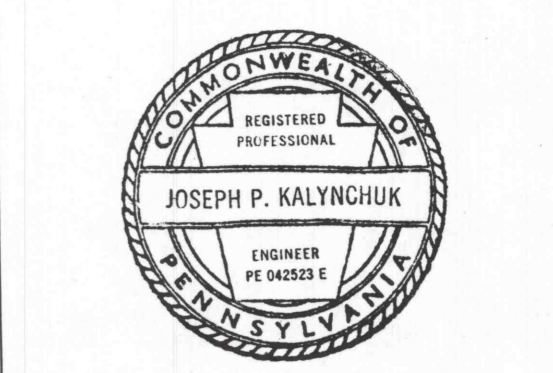

FINAL MINE MAP

SIGNATURE: *Joseph P. Kalynchuk*

DATE: 4-14-99