


MSHA I.D. No. 36-06583



Doverspike Bros. Coal Co.
R.D. #4, Box 271, Punxsutawney, PA 15767
Porter & Perry Twp., Jefferson County

DORA #6 MINE

SCALE: 1" = 200'

SHEET 20 of 24

Final Mine Map

CMAP No. 33841303

— PERMIT AREA

--- PROPERTY LINES

③① PROPERTY OWNERS

③ CONT. PROPERTY OWNERS

■ PRE-66 DWELLINGS

■ DWELLINGS, STRUCTURES

Ⓐ PROT. ACT 54 STRUCTURES

—LK-1480— L.K. COAL CONTOURS

▨ L.K. COAL OUTCROP

..... GAS LINE

⊙ GAS WELL

— T L — TELE./ELEC. LINES

● WATER WELL

○ SPRING

○ DRILL HOLE

▨ IMPOUNDMENT

◇ CEMETERY

— MINE OPENINGS, NOT SEALED

◀ MINE OPENINGS, SEALED

— STREAMS

▲₁₂ SURVEY STATION

▨ SUPPORT AREA (No Second Mining)

▨ L.F. DEEP MINE

▨ ZONE OF POTENTIAL INFLUENCE

● GAS WELL BARRIER (No Mining Within Barrier Unless Approved)

XXXXXXXX

→ INTAKE AIR

→ RETURN AIR

— BELT LINE

— STOPPING

— STOPPING W/ DOOR

— CHECK CURTAIN

— REGULATOR

— DOUBLE DOORS

— RUN-THROUGH CHECK

⊗ OVERCAST

SURVEY IS CLOSED LOOP; ACCURACY IS 1:10000


INDIVIDUALS RESPONSIBLE FOR INFORMATION:

CHARLES ISHMAN, ENGINEER & CHUCK MARTZ, SUPERINTENDENT

MAP FULFILLS REQUIREMENTS OF 75.372 & 75.1200

NO ADJACENT MINE WORKINGS WITHIN 1000 FEET

NO MINE WORKINGS BELOW MINE PROPERTY

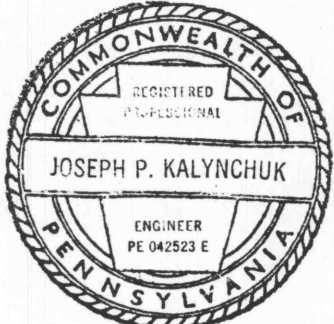

JOSEPH P. KALYNCHUK
ENGINEER

SIGNATURE

DATE 4-14-99

FINAL MINE MAP