


JACOB SNYDER

M.B. KUNSELMAN

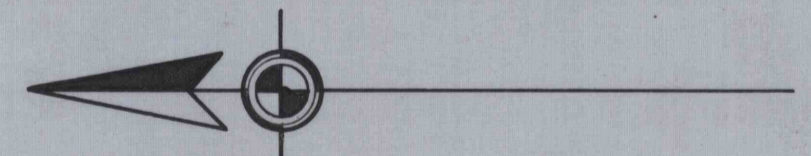

**FAIRVIEW COAL CO.,  
MINE No. 2**

**PORTER TOWNSHIP, JEFFERSON COUNTY, PA.**

SCALE 1 - 100  
OCTOBER 1947  
WALTER J. ZIMMERMAN SURVEYOR PUNXSUTAWNEY, PA.

I hereby certify that this is a true and correct copy of the original map of Fairview Coal Co., Mine No. 2, and that the original map is a true, complete, and correct map and survey of all the excavations made in said mine.

Walter J. Zimmerman  
Walter J. Zimmerman  
Reg. Surveyor No. 4940



General Survey  
June 28, 1949