


MINE MAP
FAIRVIEW COAL CO.,
MINE No. 3

PORTER TOWNSHIP, JEFFERSON COUNTY, PA.

SCALE 1" = 100'
 WALTER J. ZIMMERMAN SURVEYOR - ENGINEER PUNXSUTAWNEY, PA. MARCH, 1951

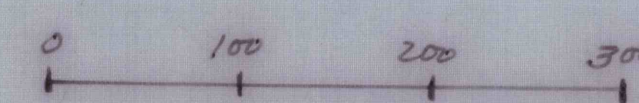

NEAL

JEF-16

Fairview Coal Co. Mine No. 3
 Porter Twp., Jefferson County

3

Handwritten notes and scribbles at the bottom right corner.