


E-1000

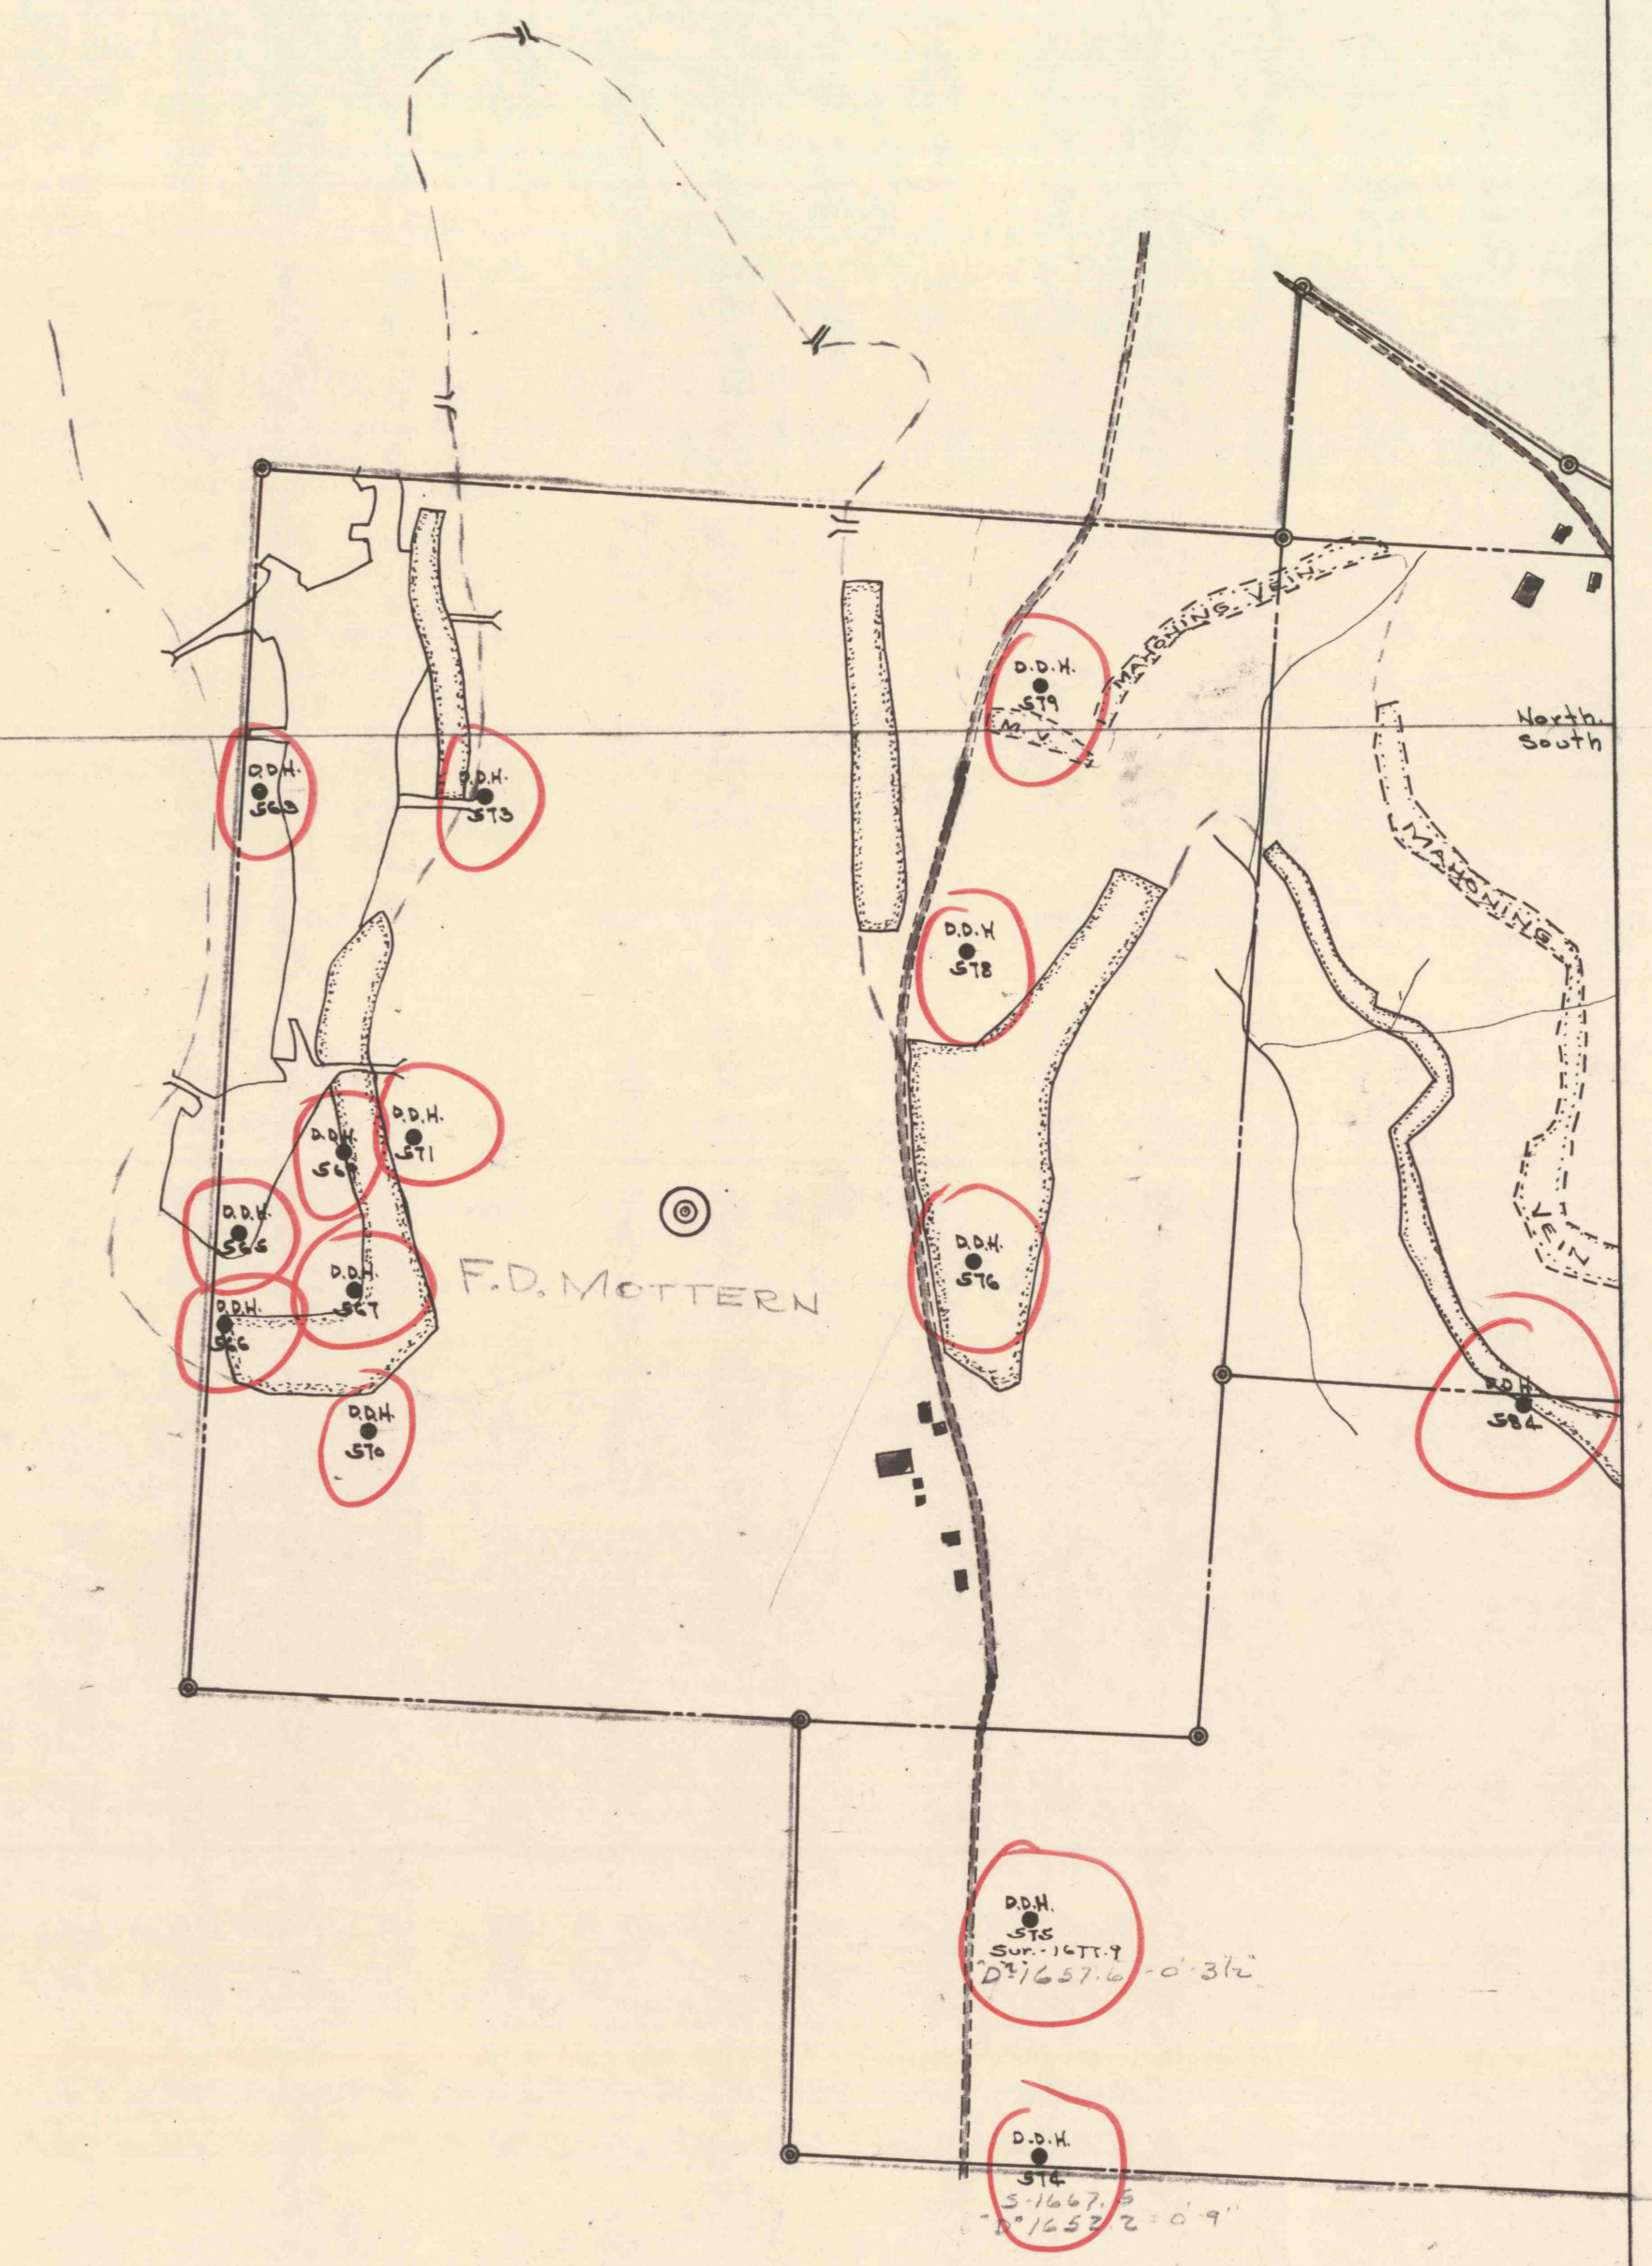

E-1000

N-2000

PEACHTREE FIELD - UPPER VEIN 1" = 400'

E-VEIN

E-1000