


CLARA NIEL AND JAMES NIEL HEIRS

JOHN, JAMES & CLARA NIEL

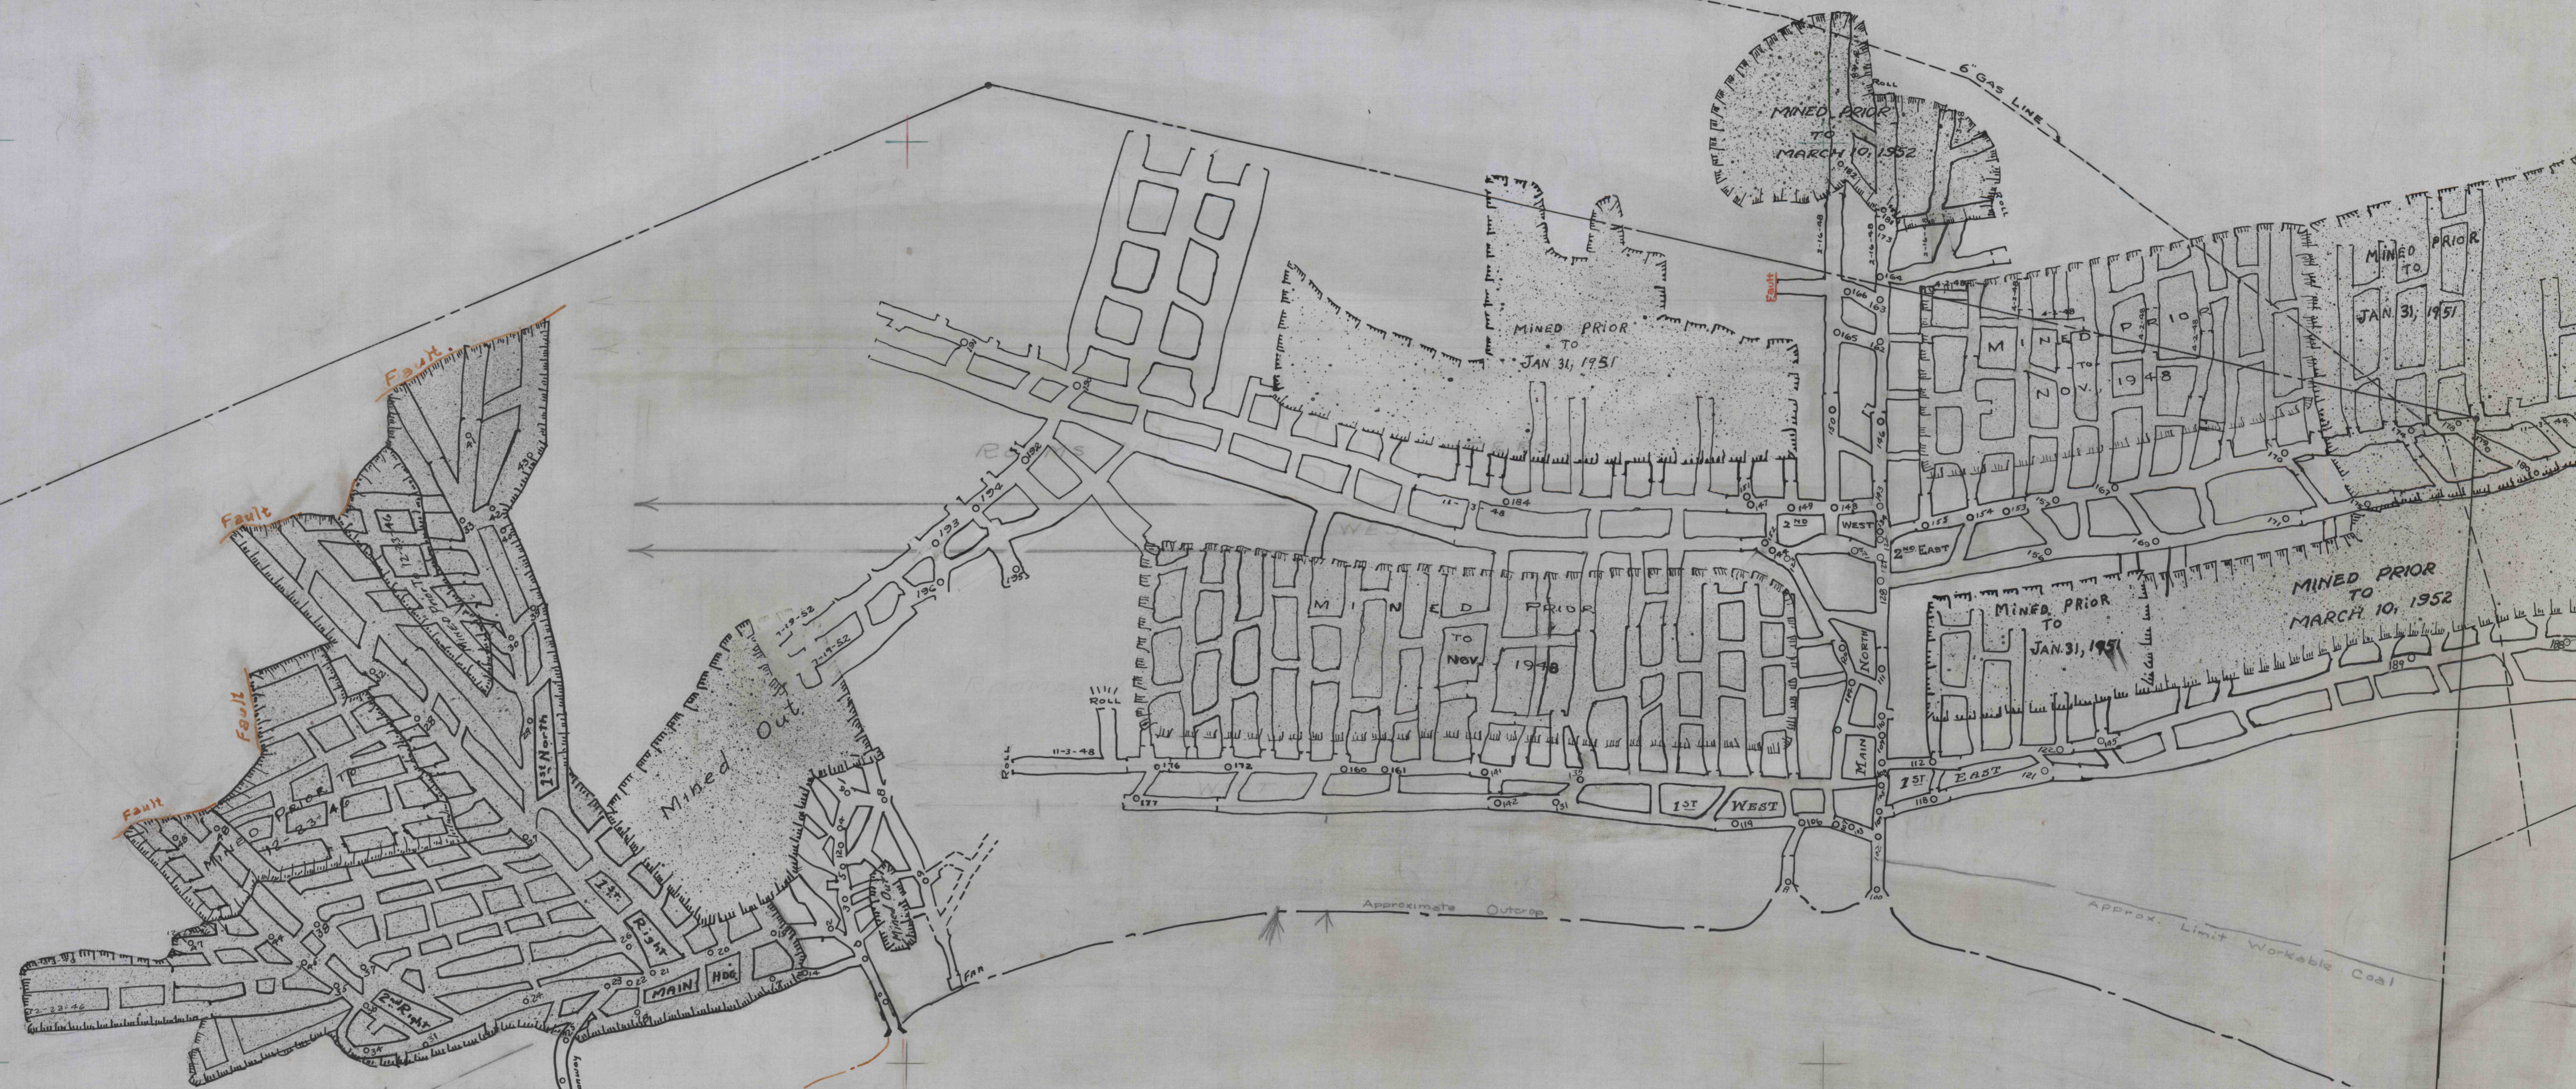

PUNXSUTAWNEY FUEL CO. INC.

MINE MAP

NEALE MINE

PERRY TOWNSHIP, JEFFERSON COUNTY, PA.

SCALE 1" = 100' | SEPT., 1943

WALTER J. ZIMMERMAN  
SURVEYOR  
PUNXSUTAWNEY, PA.



P1-73C

75°00'

10/11

||||| 21