


JE-50

Warrant N^o 2419


WHITEHEAD LANDS

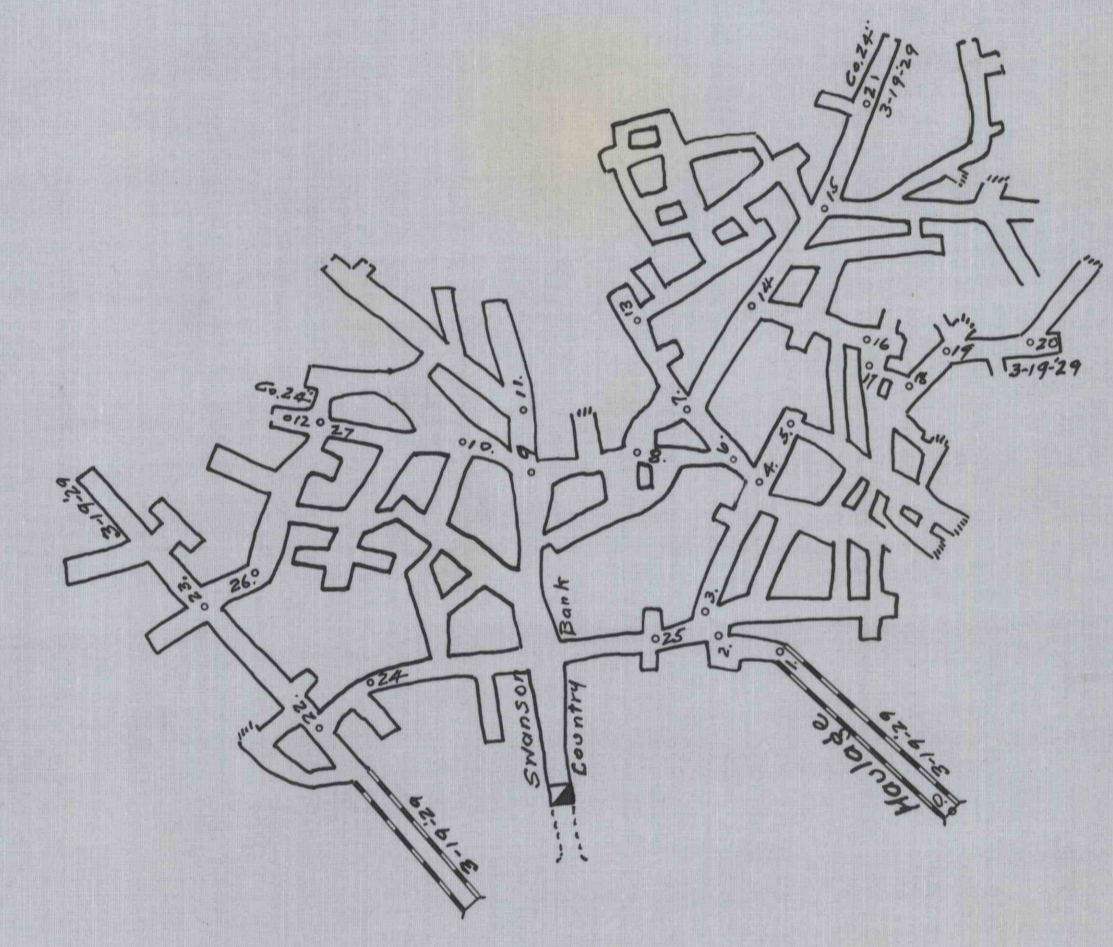

JACOB STRAITIFF EST.

WALKER & KNAPPENBERGER SUR.
Warrant 2626 N^o 6-77

SURVEYS
Mar 19, 1929

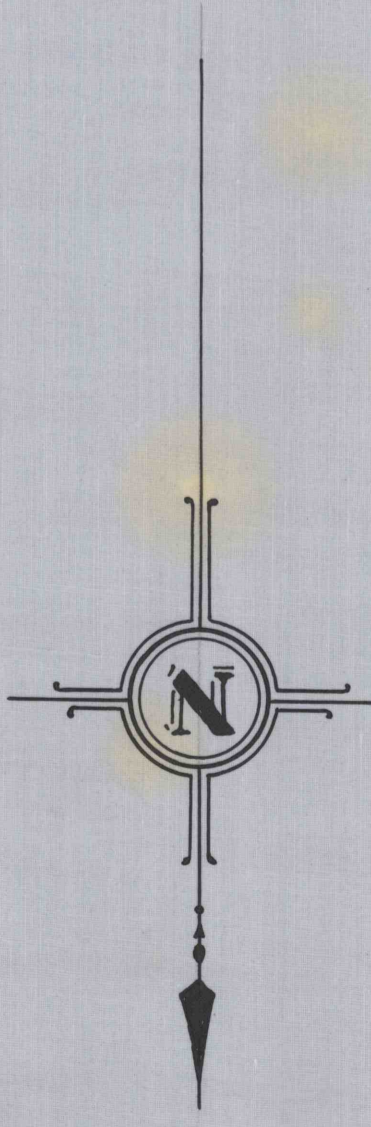

MINE MAP

OF

CORTEZ COAL CO.

WHITEHEAD N^o 1 MINE

M^o CALMONT TWP. JEFFERSON CO. PA.

Scale 1"=100' May 14, 1929

The H.M. Kanarr Co.
Mining Engineers
Punxsutawney, Pa.