


LEON H. HOFFMAN

GAS WELL
O

GAS WELL
O

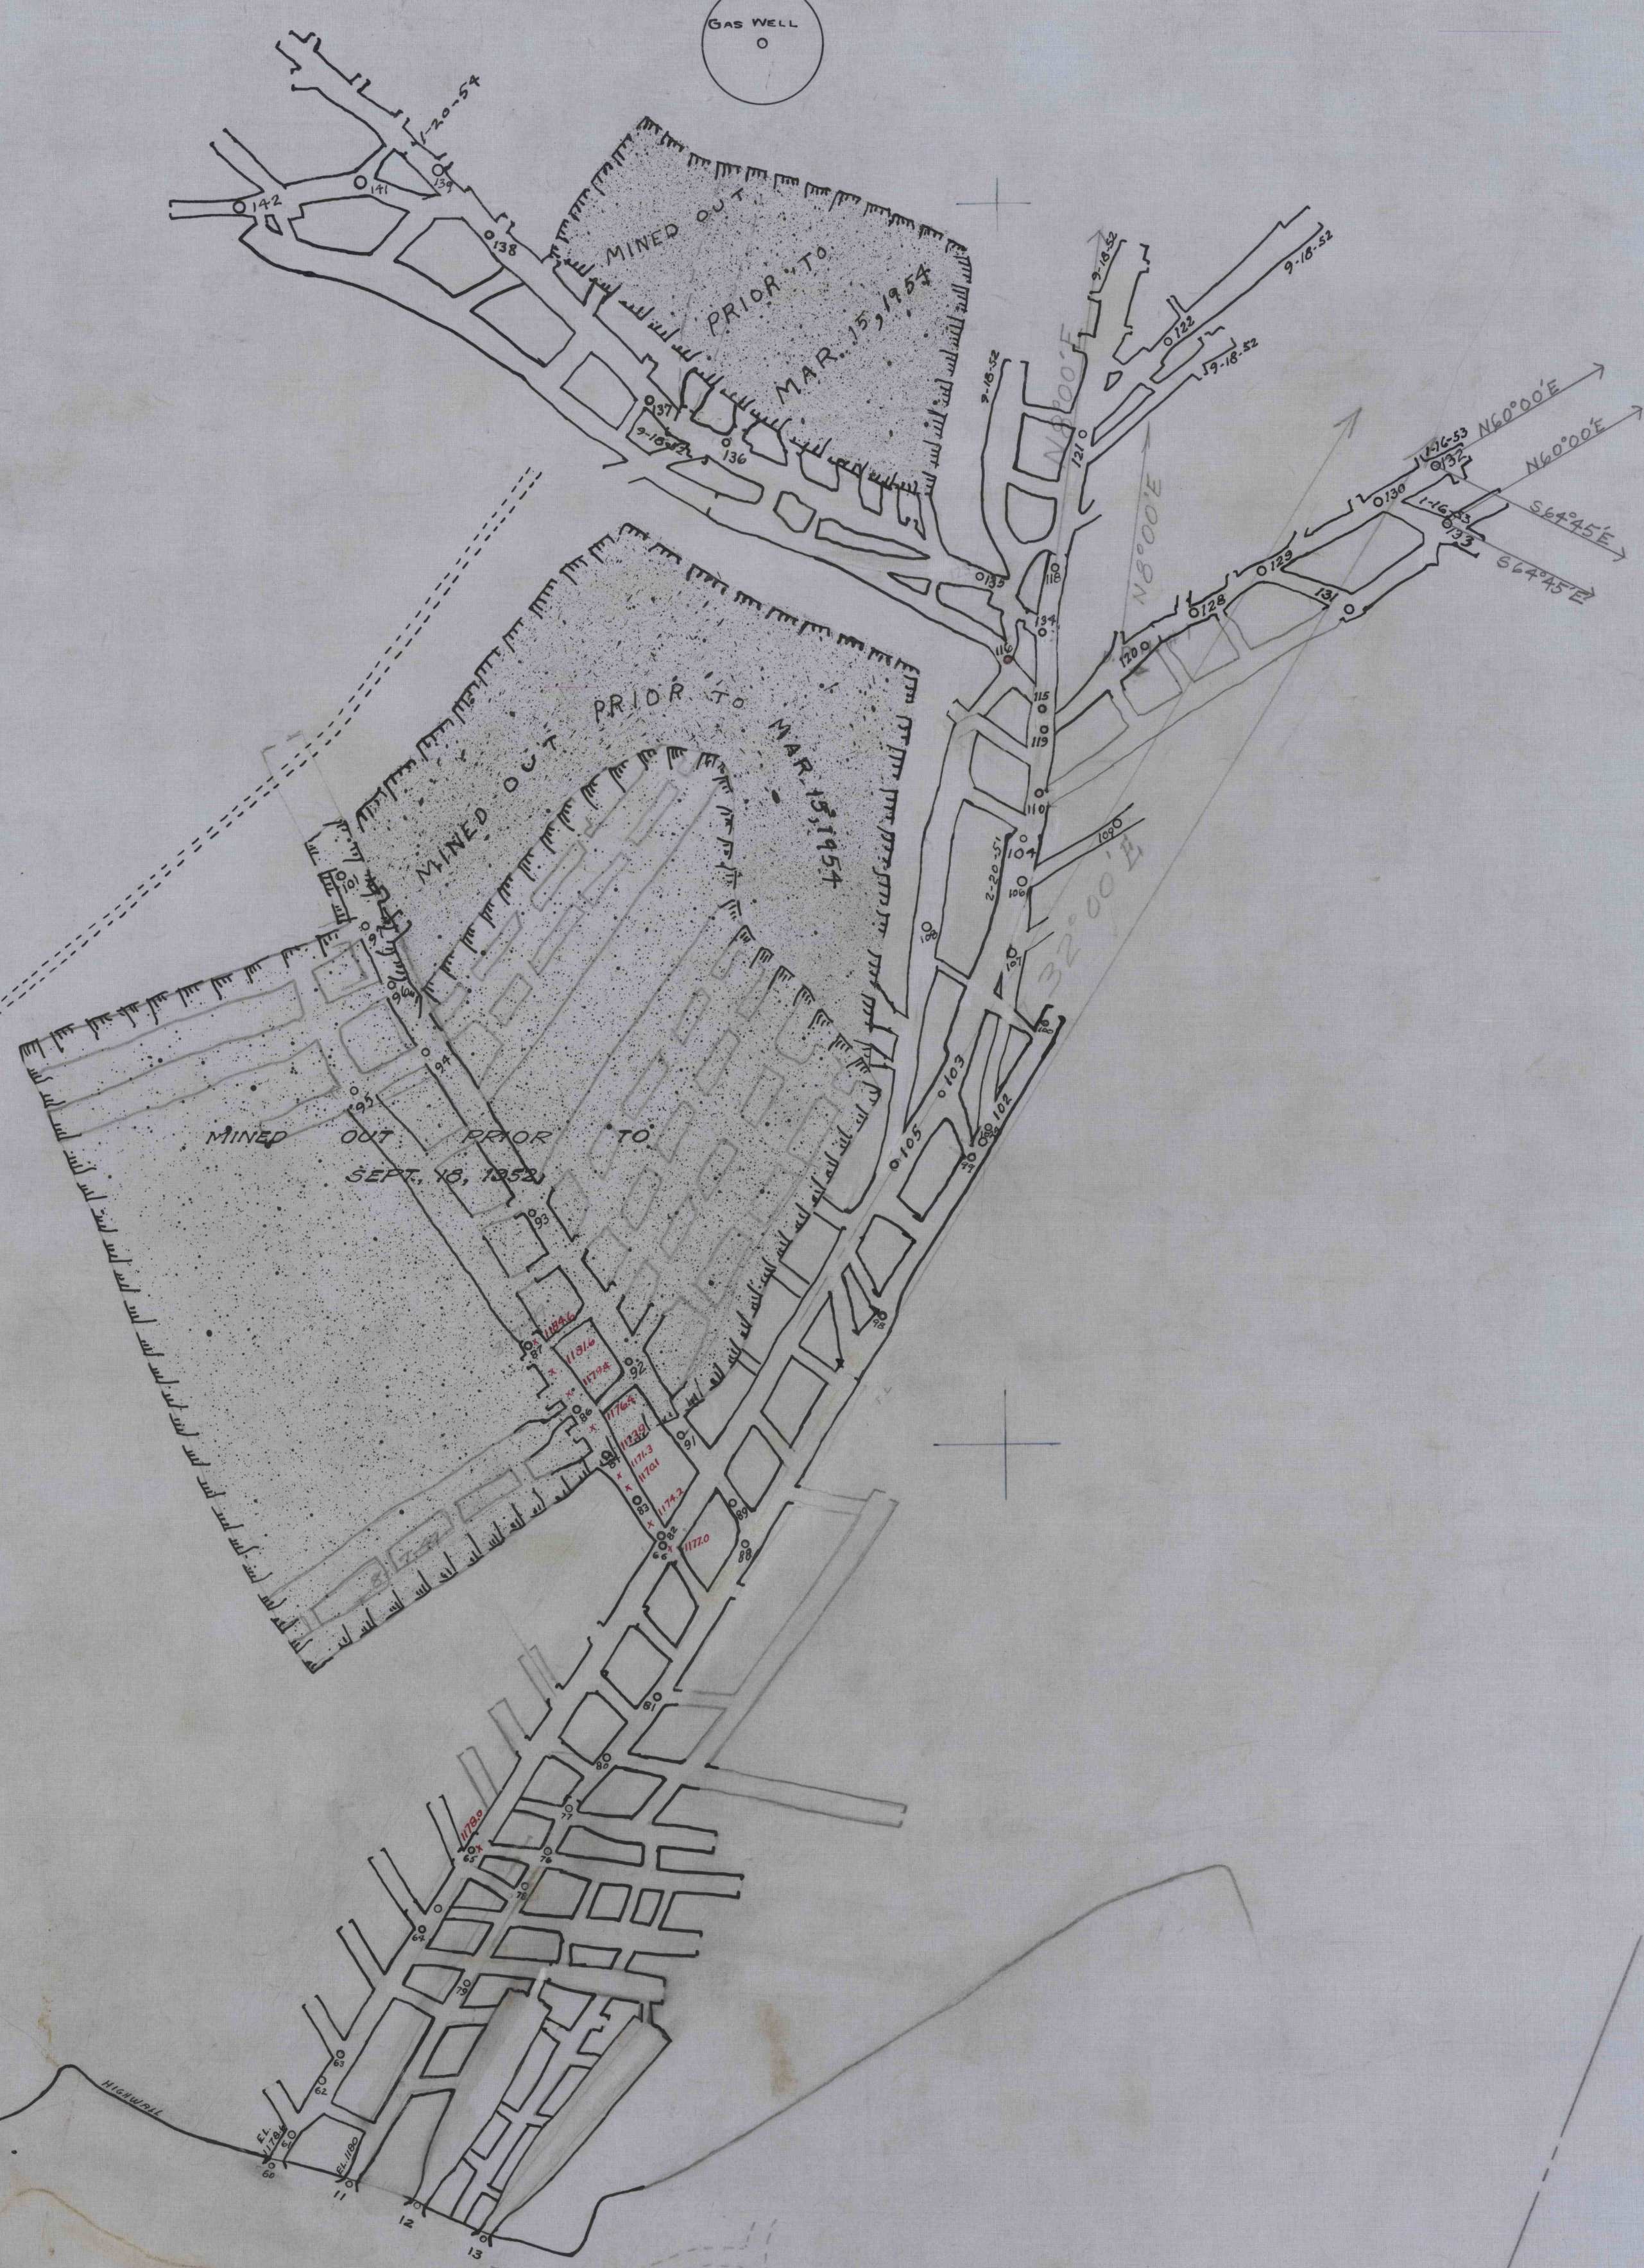


ROBERT HAMILTON

MINE MAP
PERRYVILLE COAL COMPANY
MINE NO. 1

PERRY TOWNSHIP
SCALE 1"=100'
WALTER J. ZIMMERMAN

JEFFERSON COUNTY
NOVEMBER, 1948
PUNXSUTAWNEY, PA.

SURVEYOR

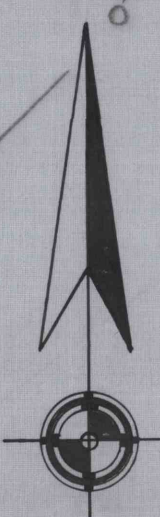

LK coal

106-55