

Surface Elev 1000.0
Assumed Datum

JNO. WOOD


S. J. M^c MANIGLE

D. HEASLEY

D. JONES

L. C. M^c MANIGLE

S. J. M^c MANIGLE

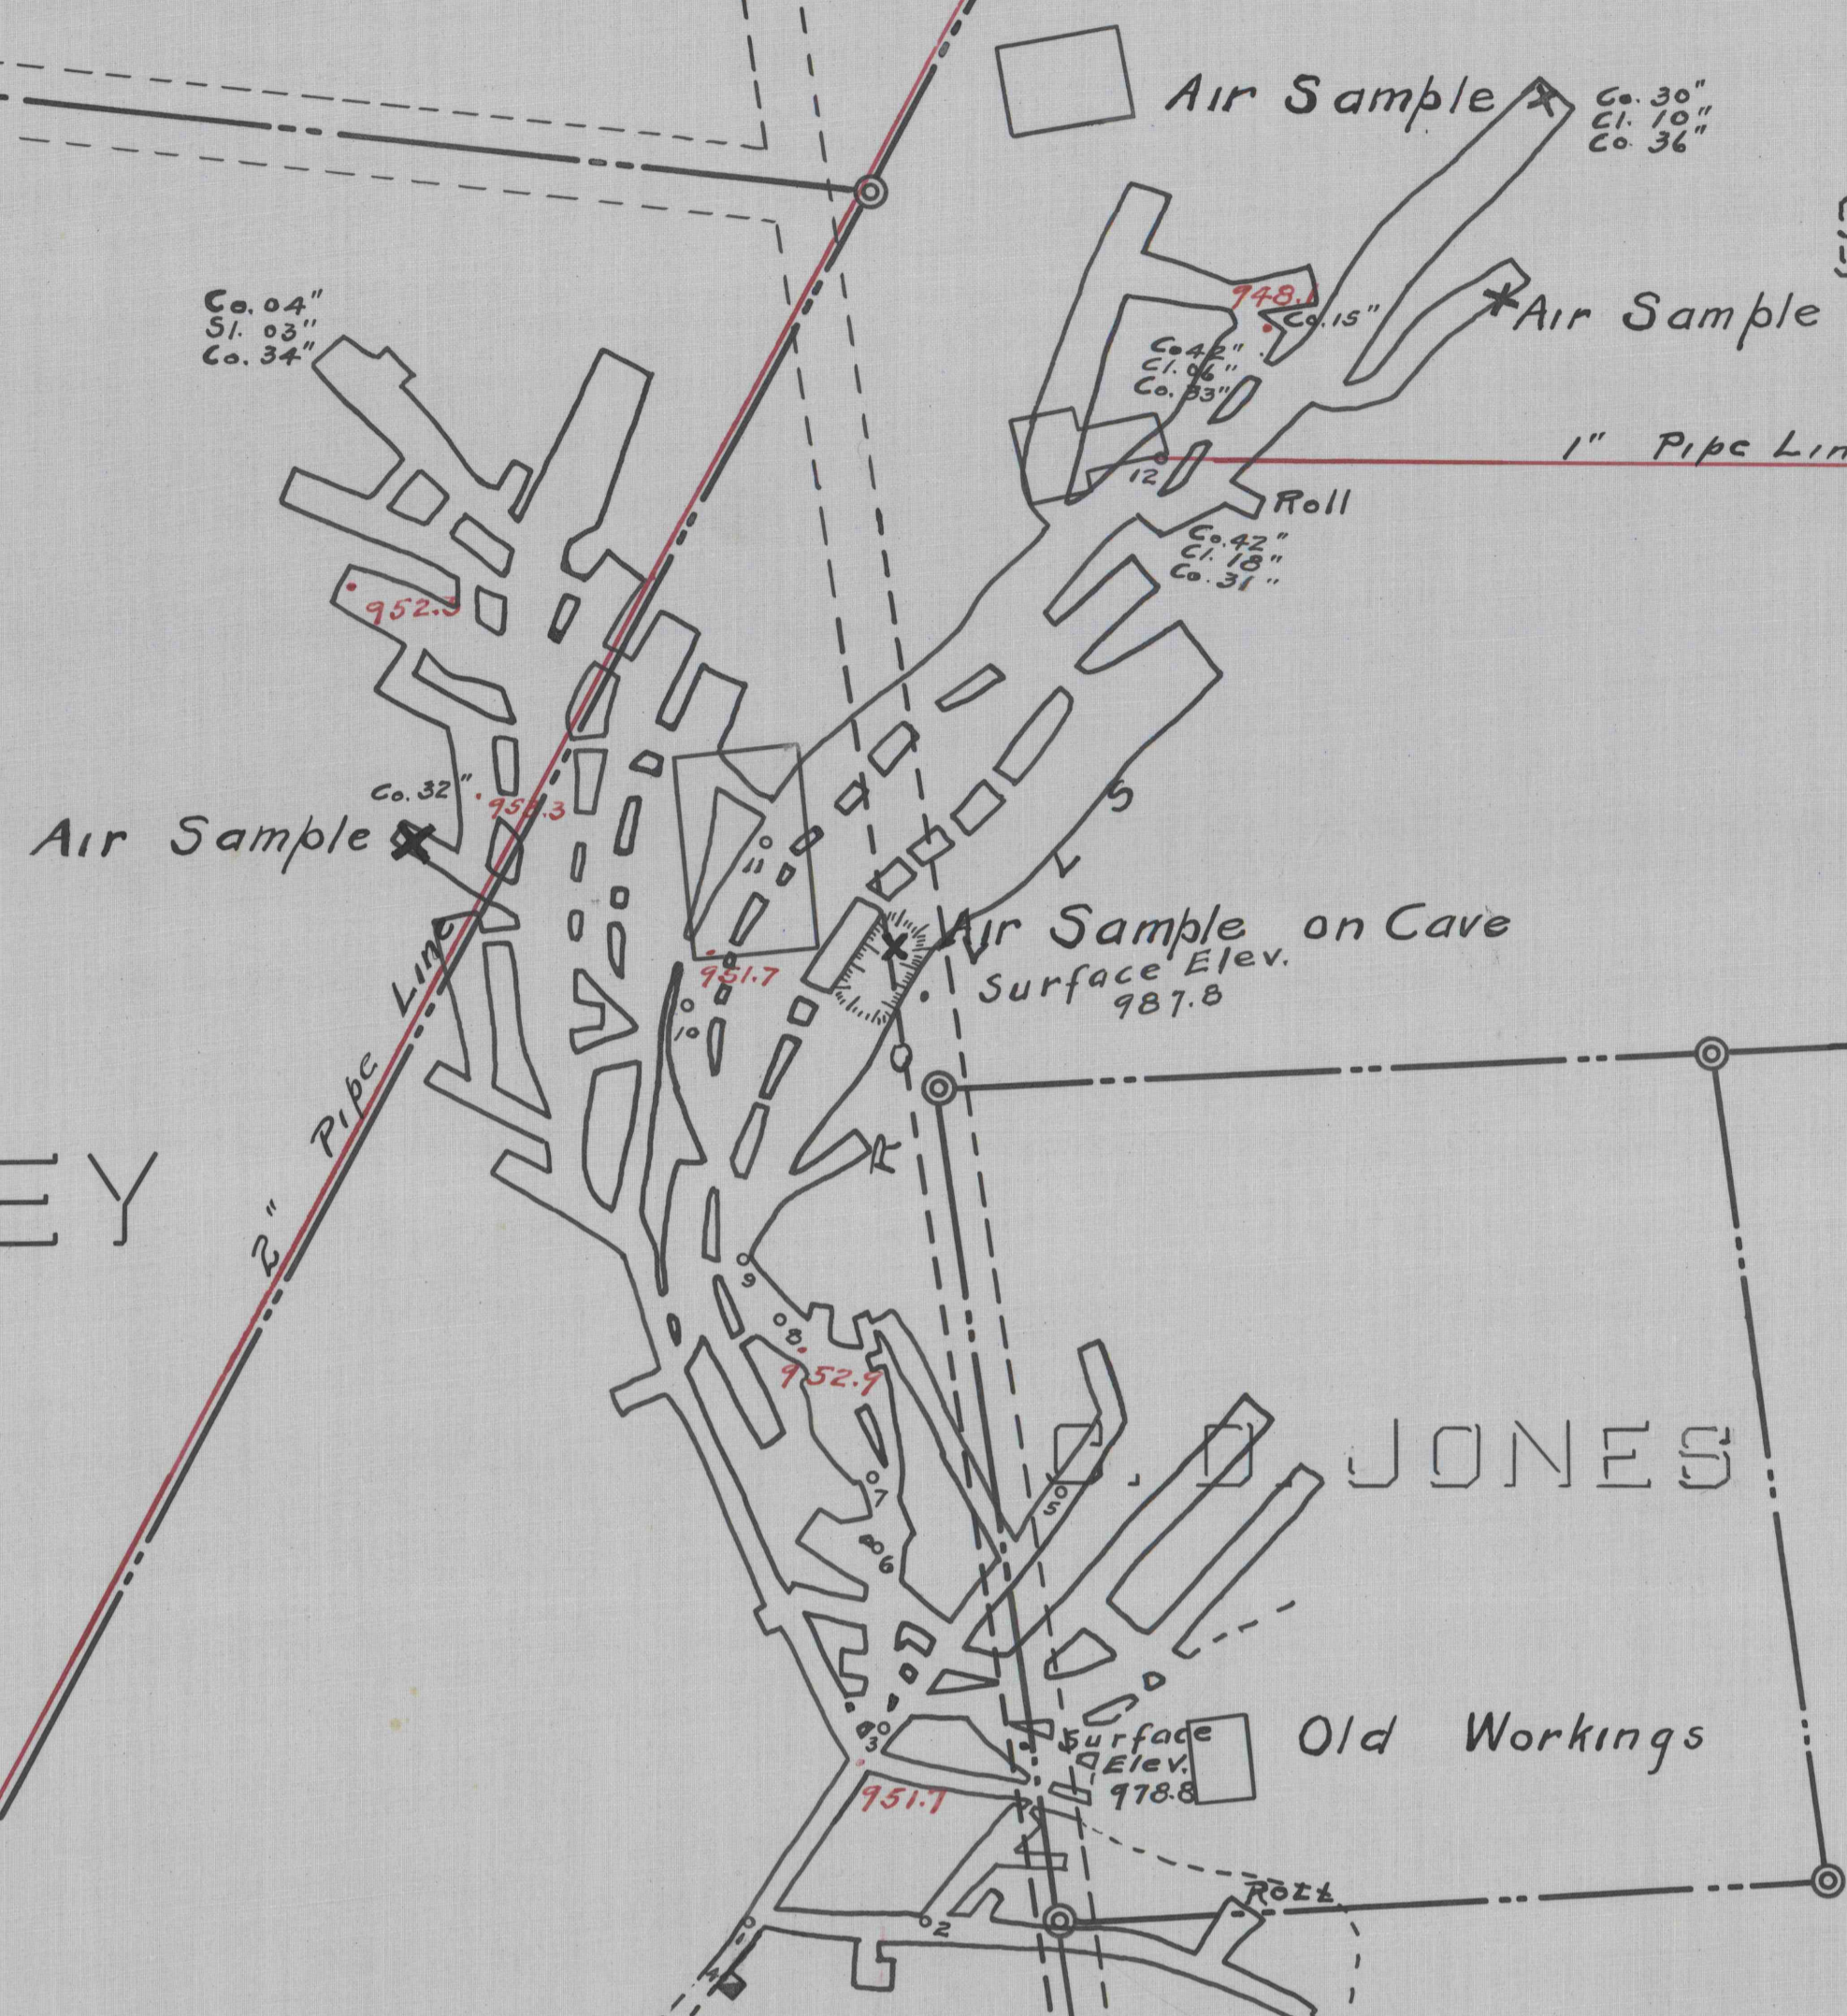

Old Mine

Old Workings

HANLEY AND BIRD

Map Showing Mine Workings on S. J. M^c Manigle Farm and Adjacent Surface Topography

Scale 1" = 50'

Brookville Pa Dec. 1922

H.M. Kanarr Engr.

J. S. Scott Mgr.

