


DEPP & COOK MINE
SITUATE NEAR
HAMILTON, PA.

Scale 1"=100'
Mar. 1923.

H.M. Kanarr, Eng'r.
Punxsutawney, Pa.

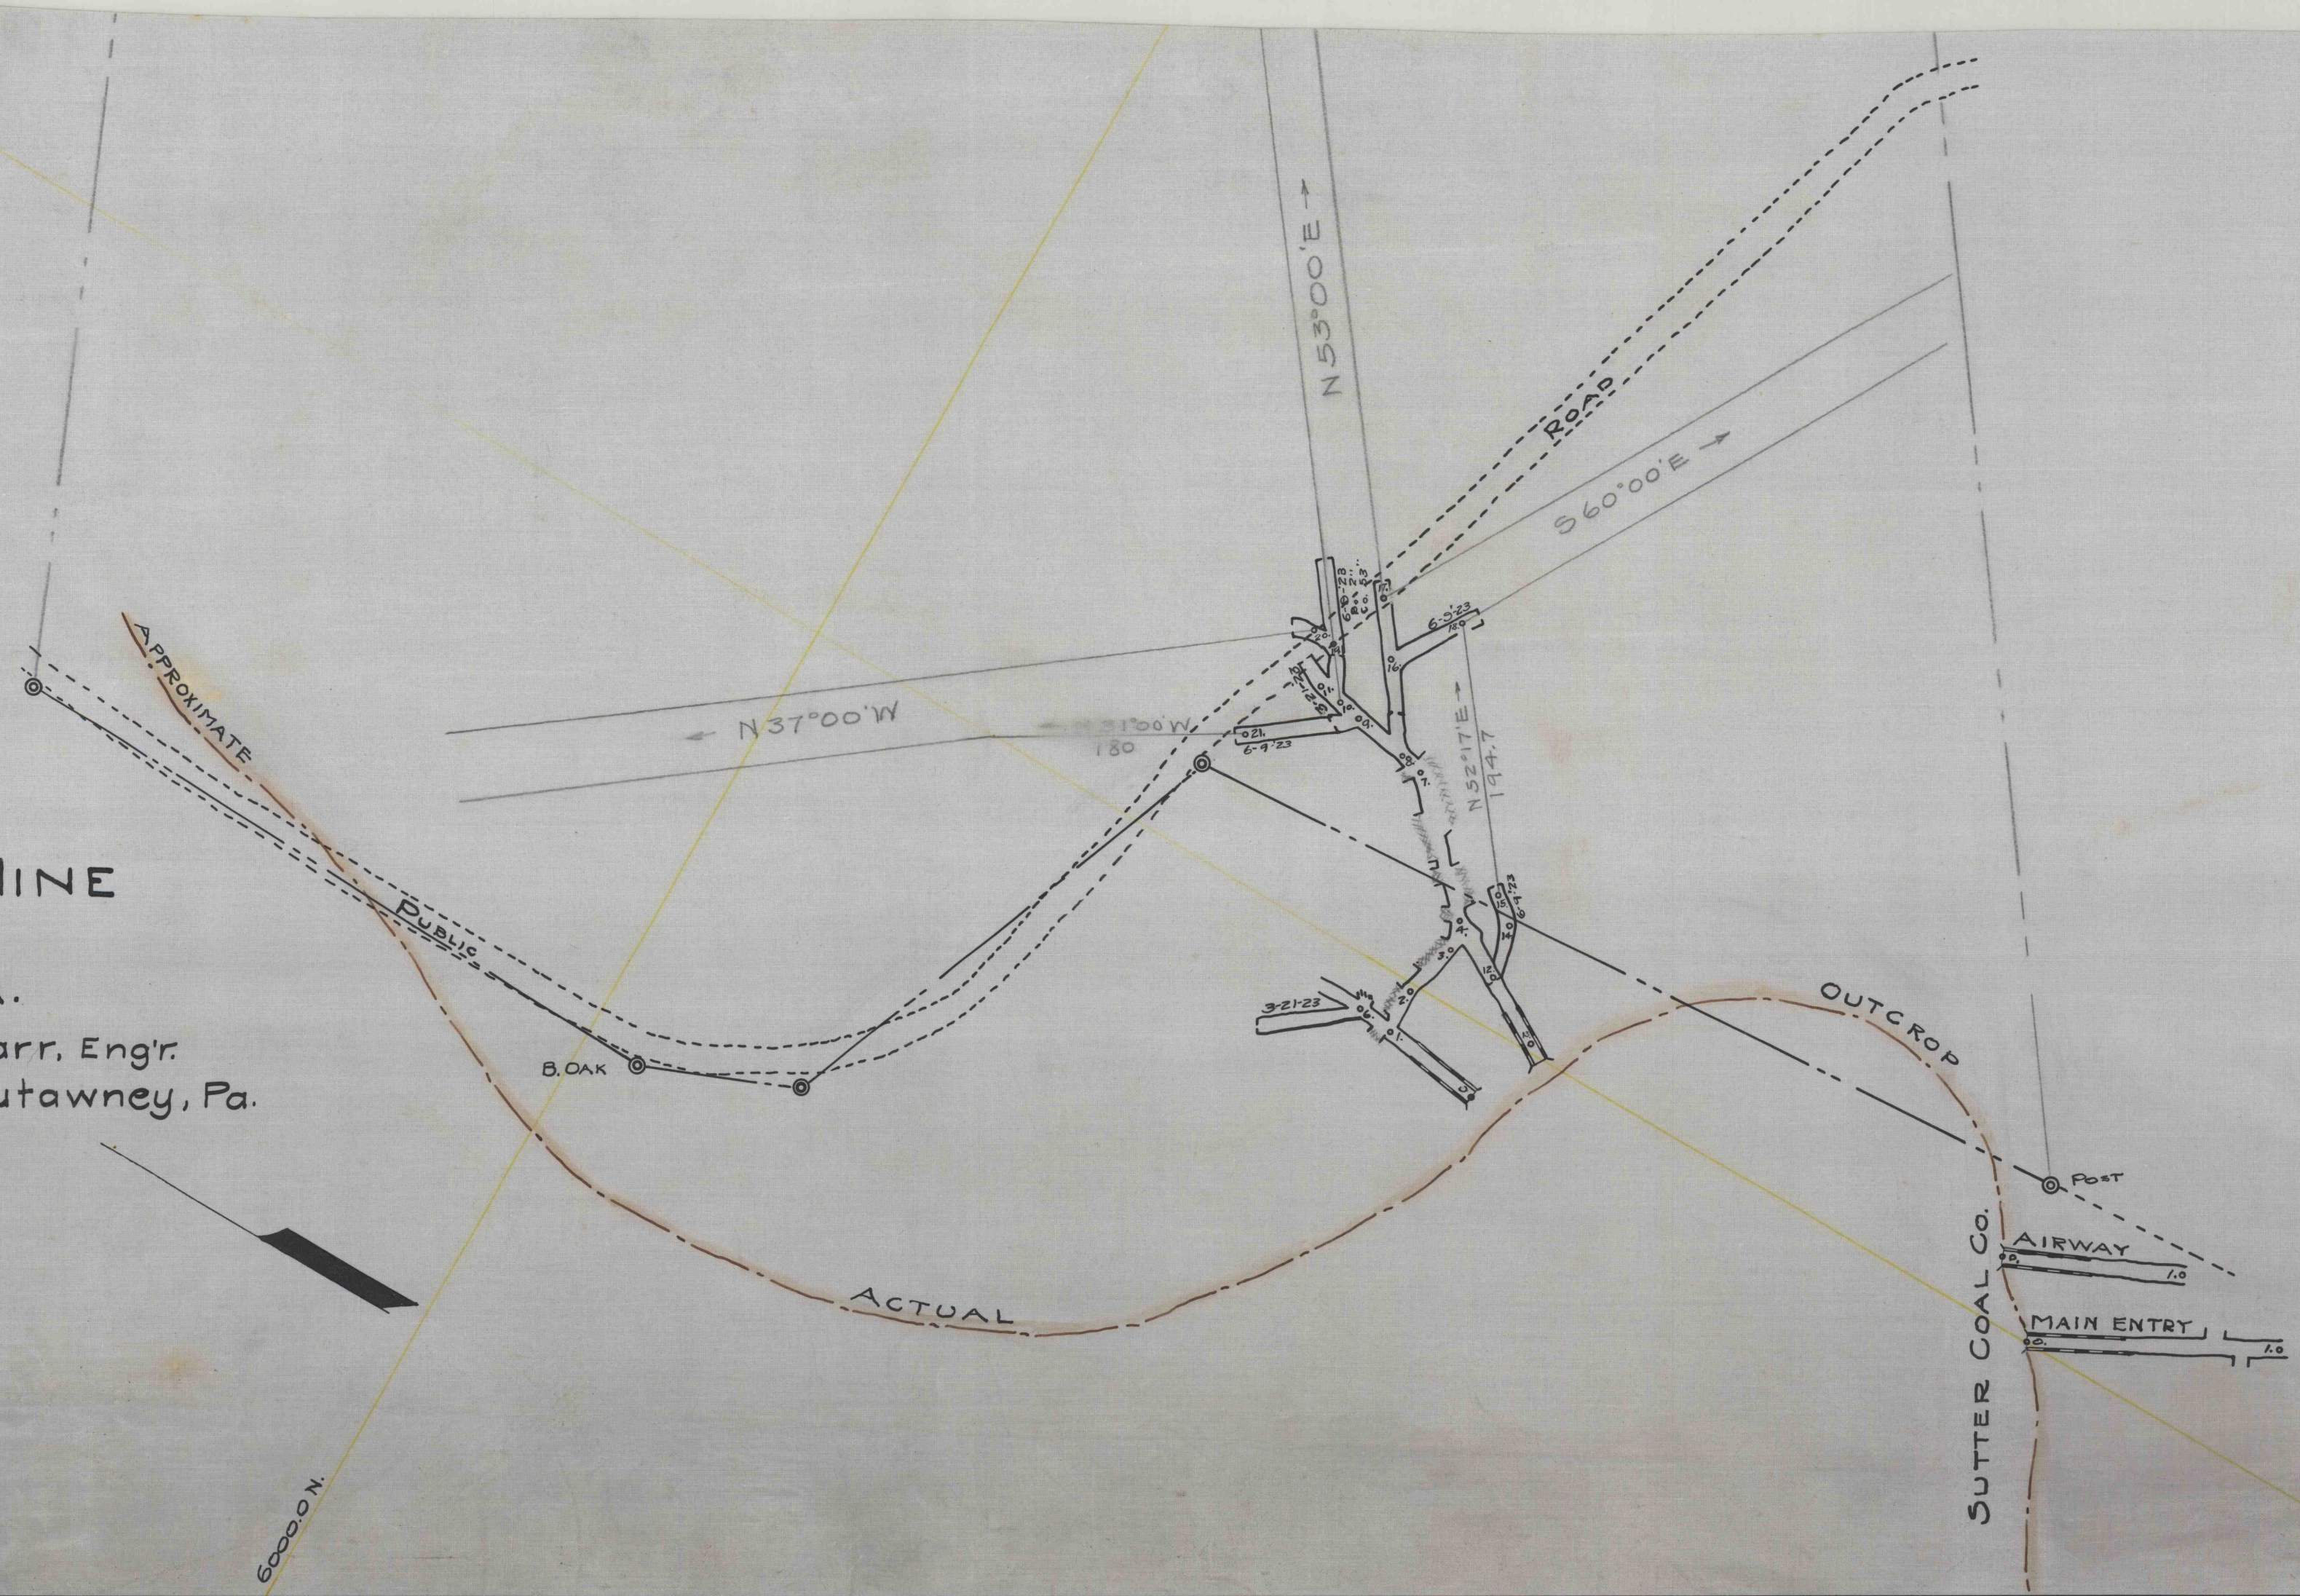

2-B-5
185-51