



ISAAC BROCIUS HEIRS

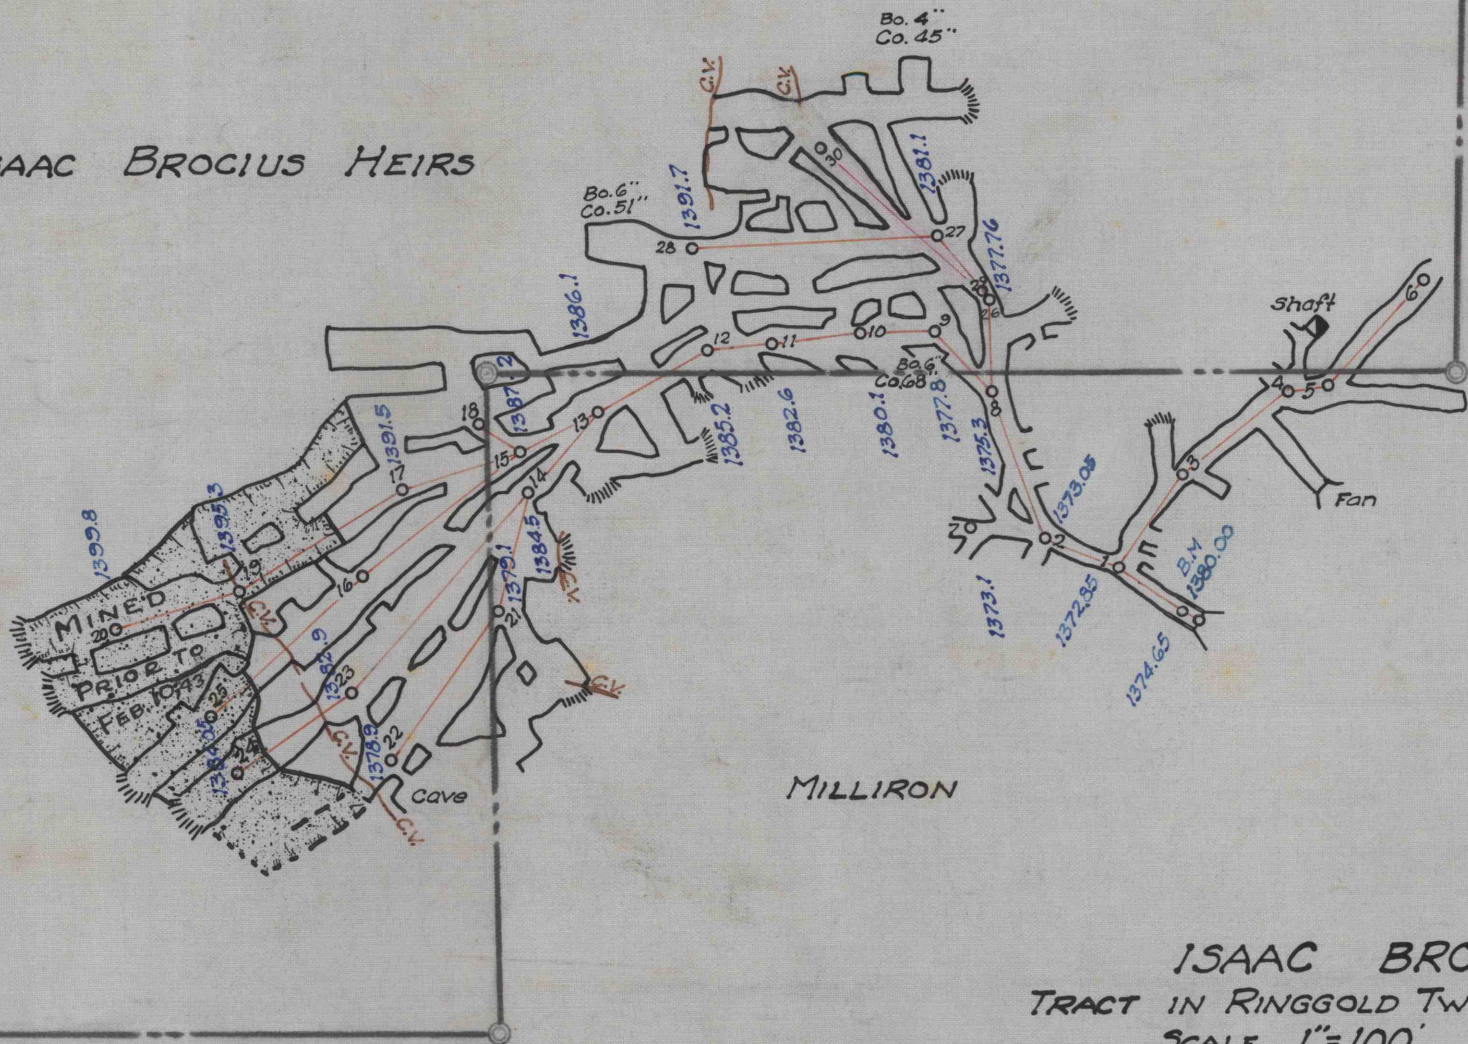

BUFFINGTON

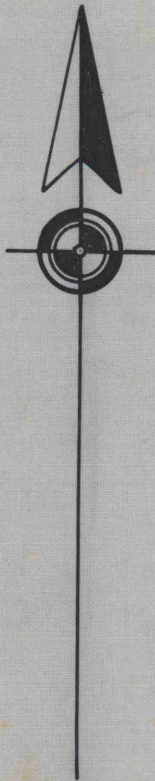

AMOS DEIBLER

ISAAC BROSIUS HEIRS  
TRACT IN RINGGOLD TWP. JEFFERSON CO. PENNA.  
SCALE 1"=100' AUGUST 1942  
WALTER J. ZIMMERMAN  
SURVEYOR  
PUNXSUTAWNEY PENNA.

156-52  
C. J. ...