


16000 N.

12000 N.

8000 N.

4000 N.

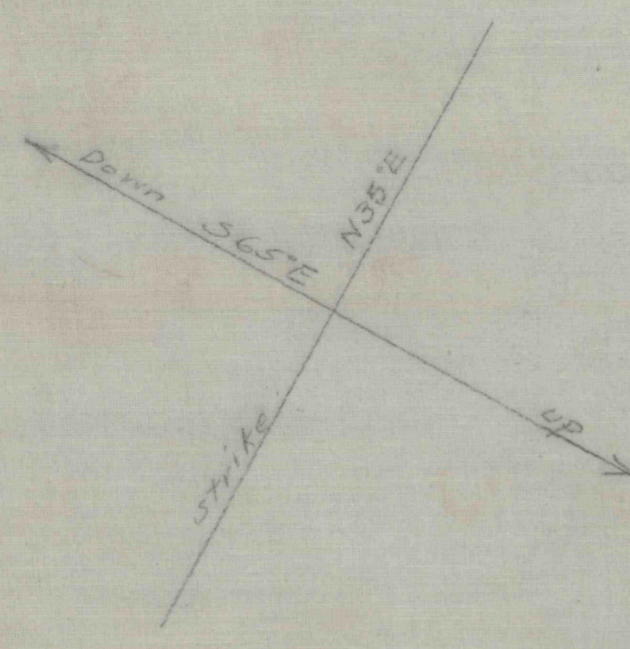

PROPERTY MAP  
 OF  
 ST. MARYS SEWER PIPE CO.

COAL MINE  
 Dora, Jefferson County, Penn'a.  
 Scale 1"=400'  
 November 1925  
 The H.M. Kenarr Co.  
 Engineers  
 PUNXSUTANNY, Pa.