


HADDON TRACT
FEE

R. E. HAMILTON

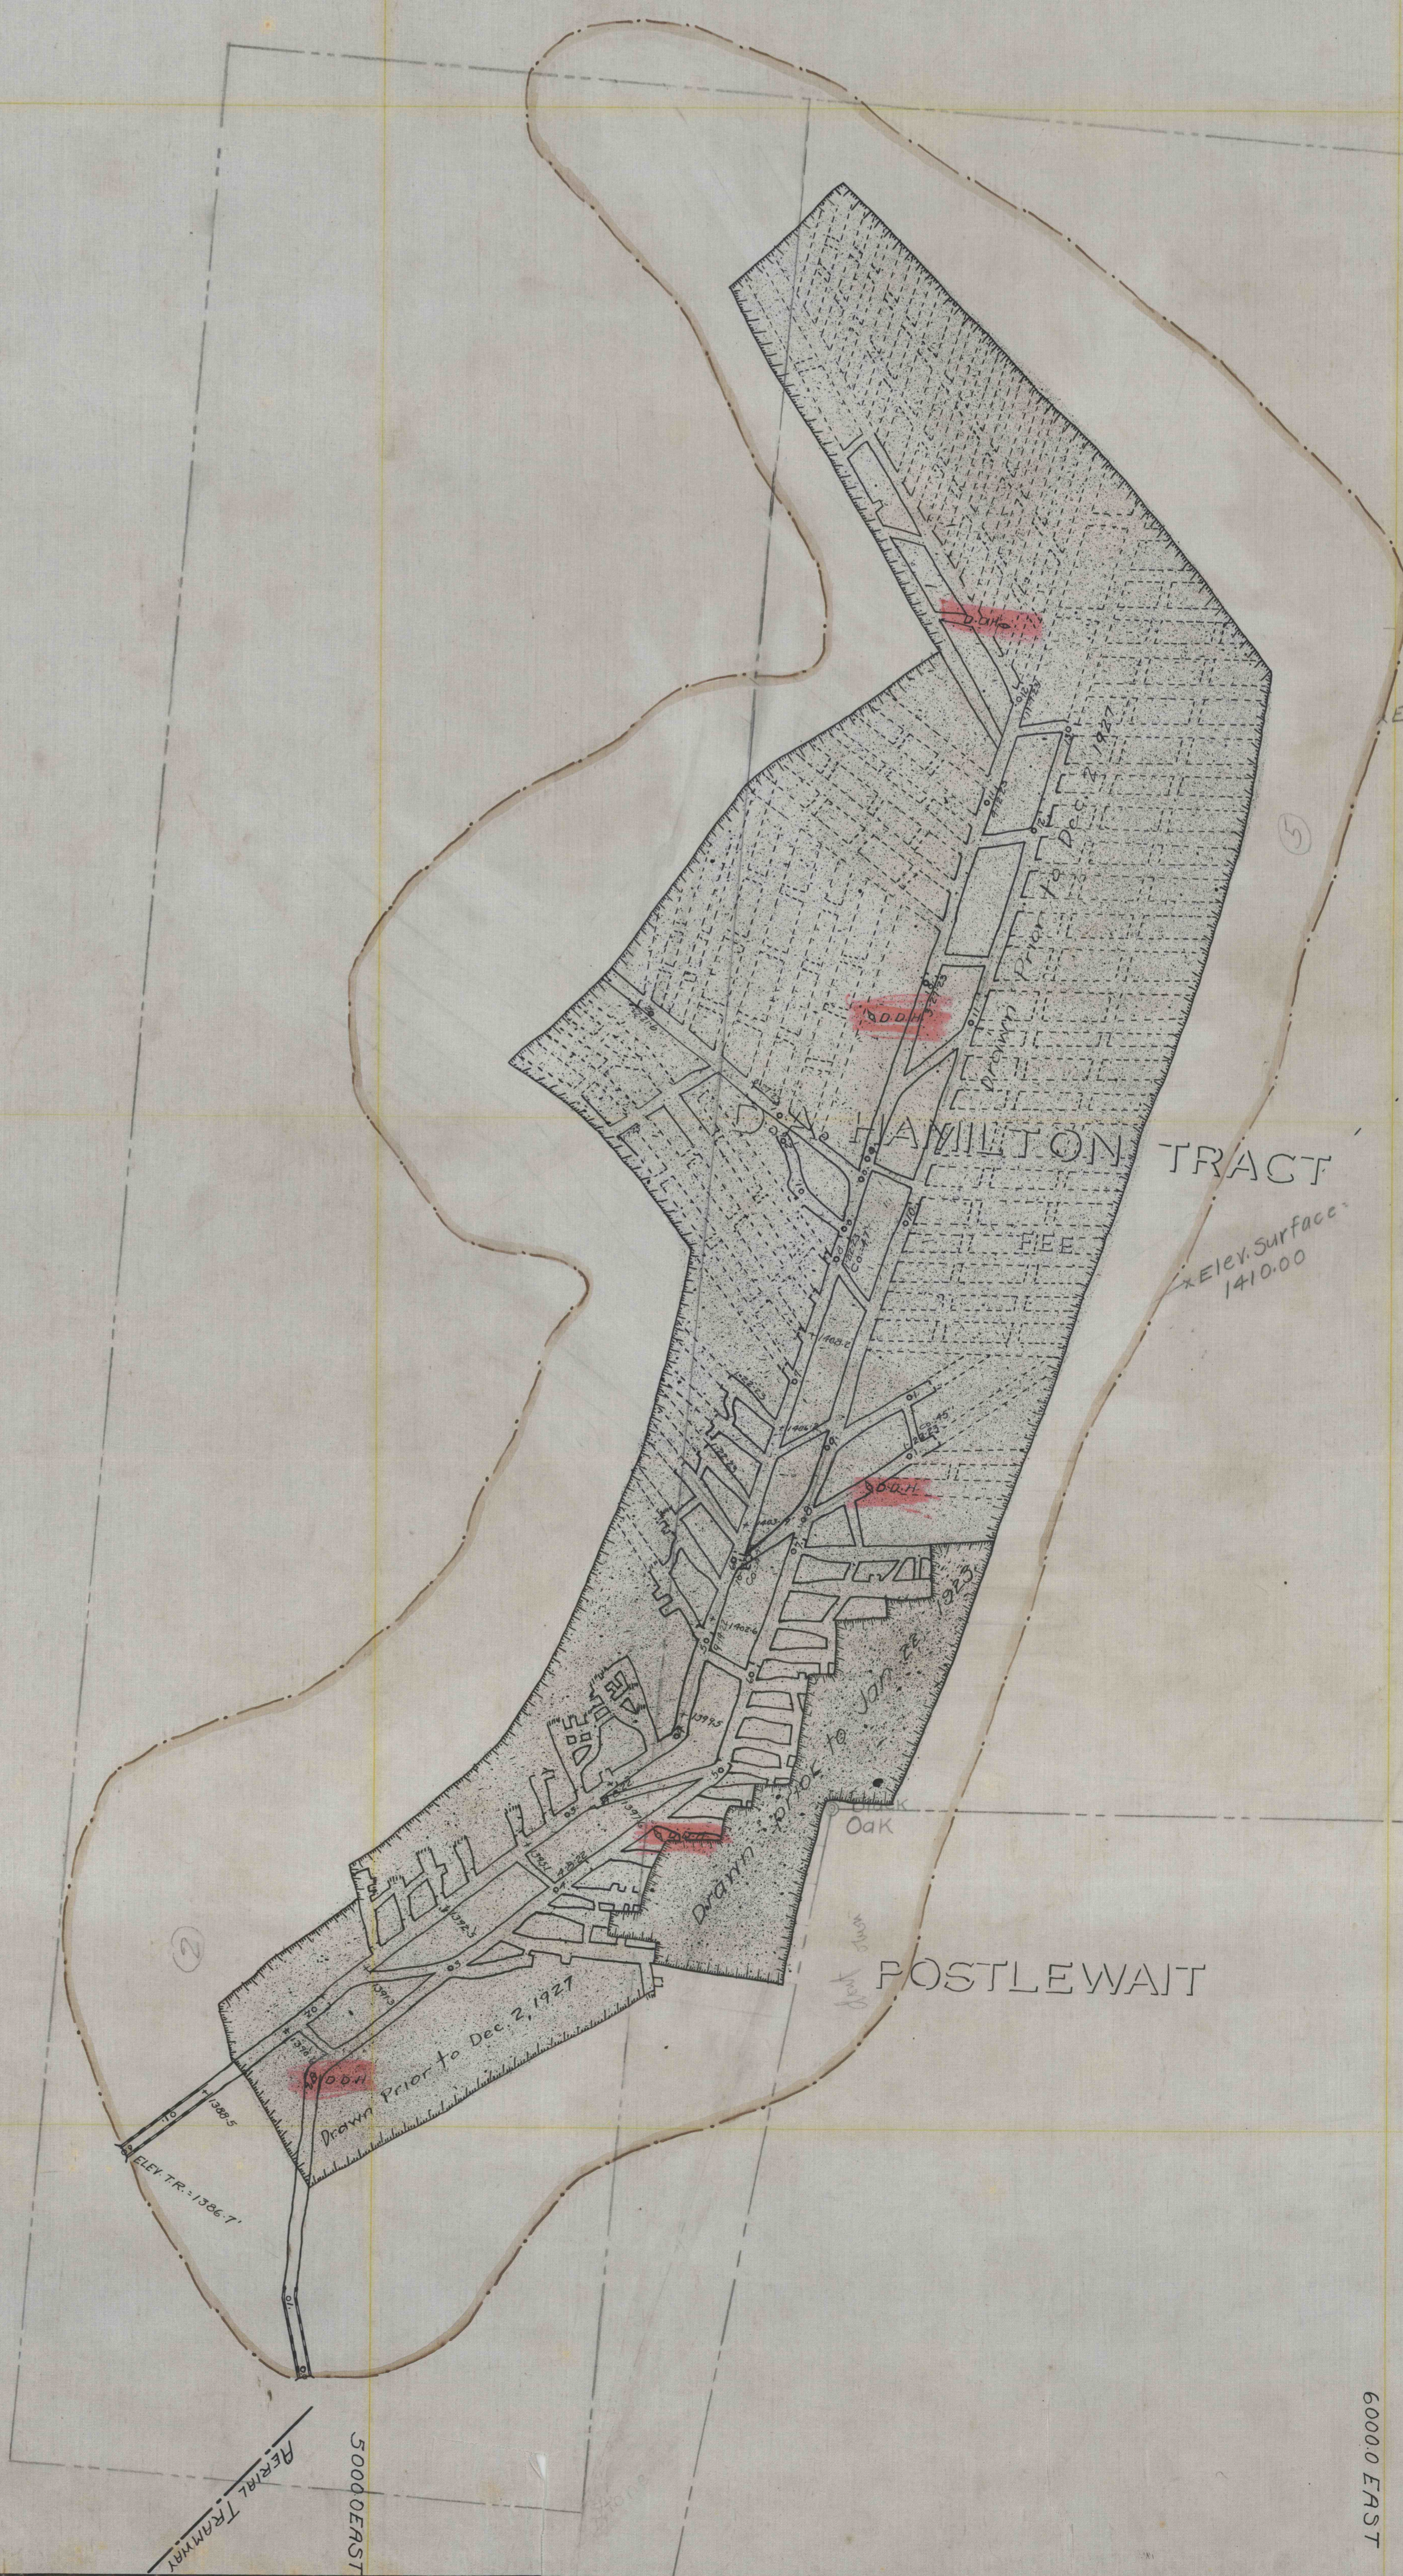

MINE MAP

OF

PERRY HILLS COAL CO.

PERRY TWP,

JEFF. CO., PA.

Scale 1 in. = 100 ft.
Aug. 1921.

H. M. Kanarr Engr.
Punxsutawney, Pa.

3000.0 NORTH

2000.0 NORTH

1000.0 NORTH

x Elev. Surface 1392.0

Elev. Surface 1413.9

Elev. Surface 1410.0

0 NORTH
0 SOUTH

1000.0 SOUTH

6000.0 EAST

3000.0 EAST

4000.0 EAST

JPL-30

3-0-23