

4.41 AC.

J. J. HAMILTON

94.90 AC.

HADDON TRACT

1st Piece

2nd Piece


FEE

8.03 AC.

23.01 AC.

D. A. HAMILTON

R. E. HAMILTON

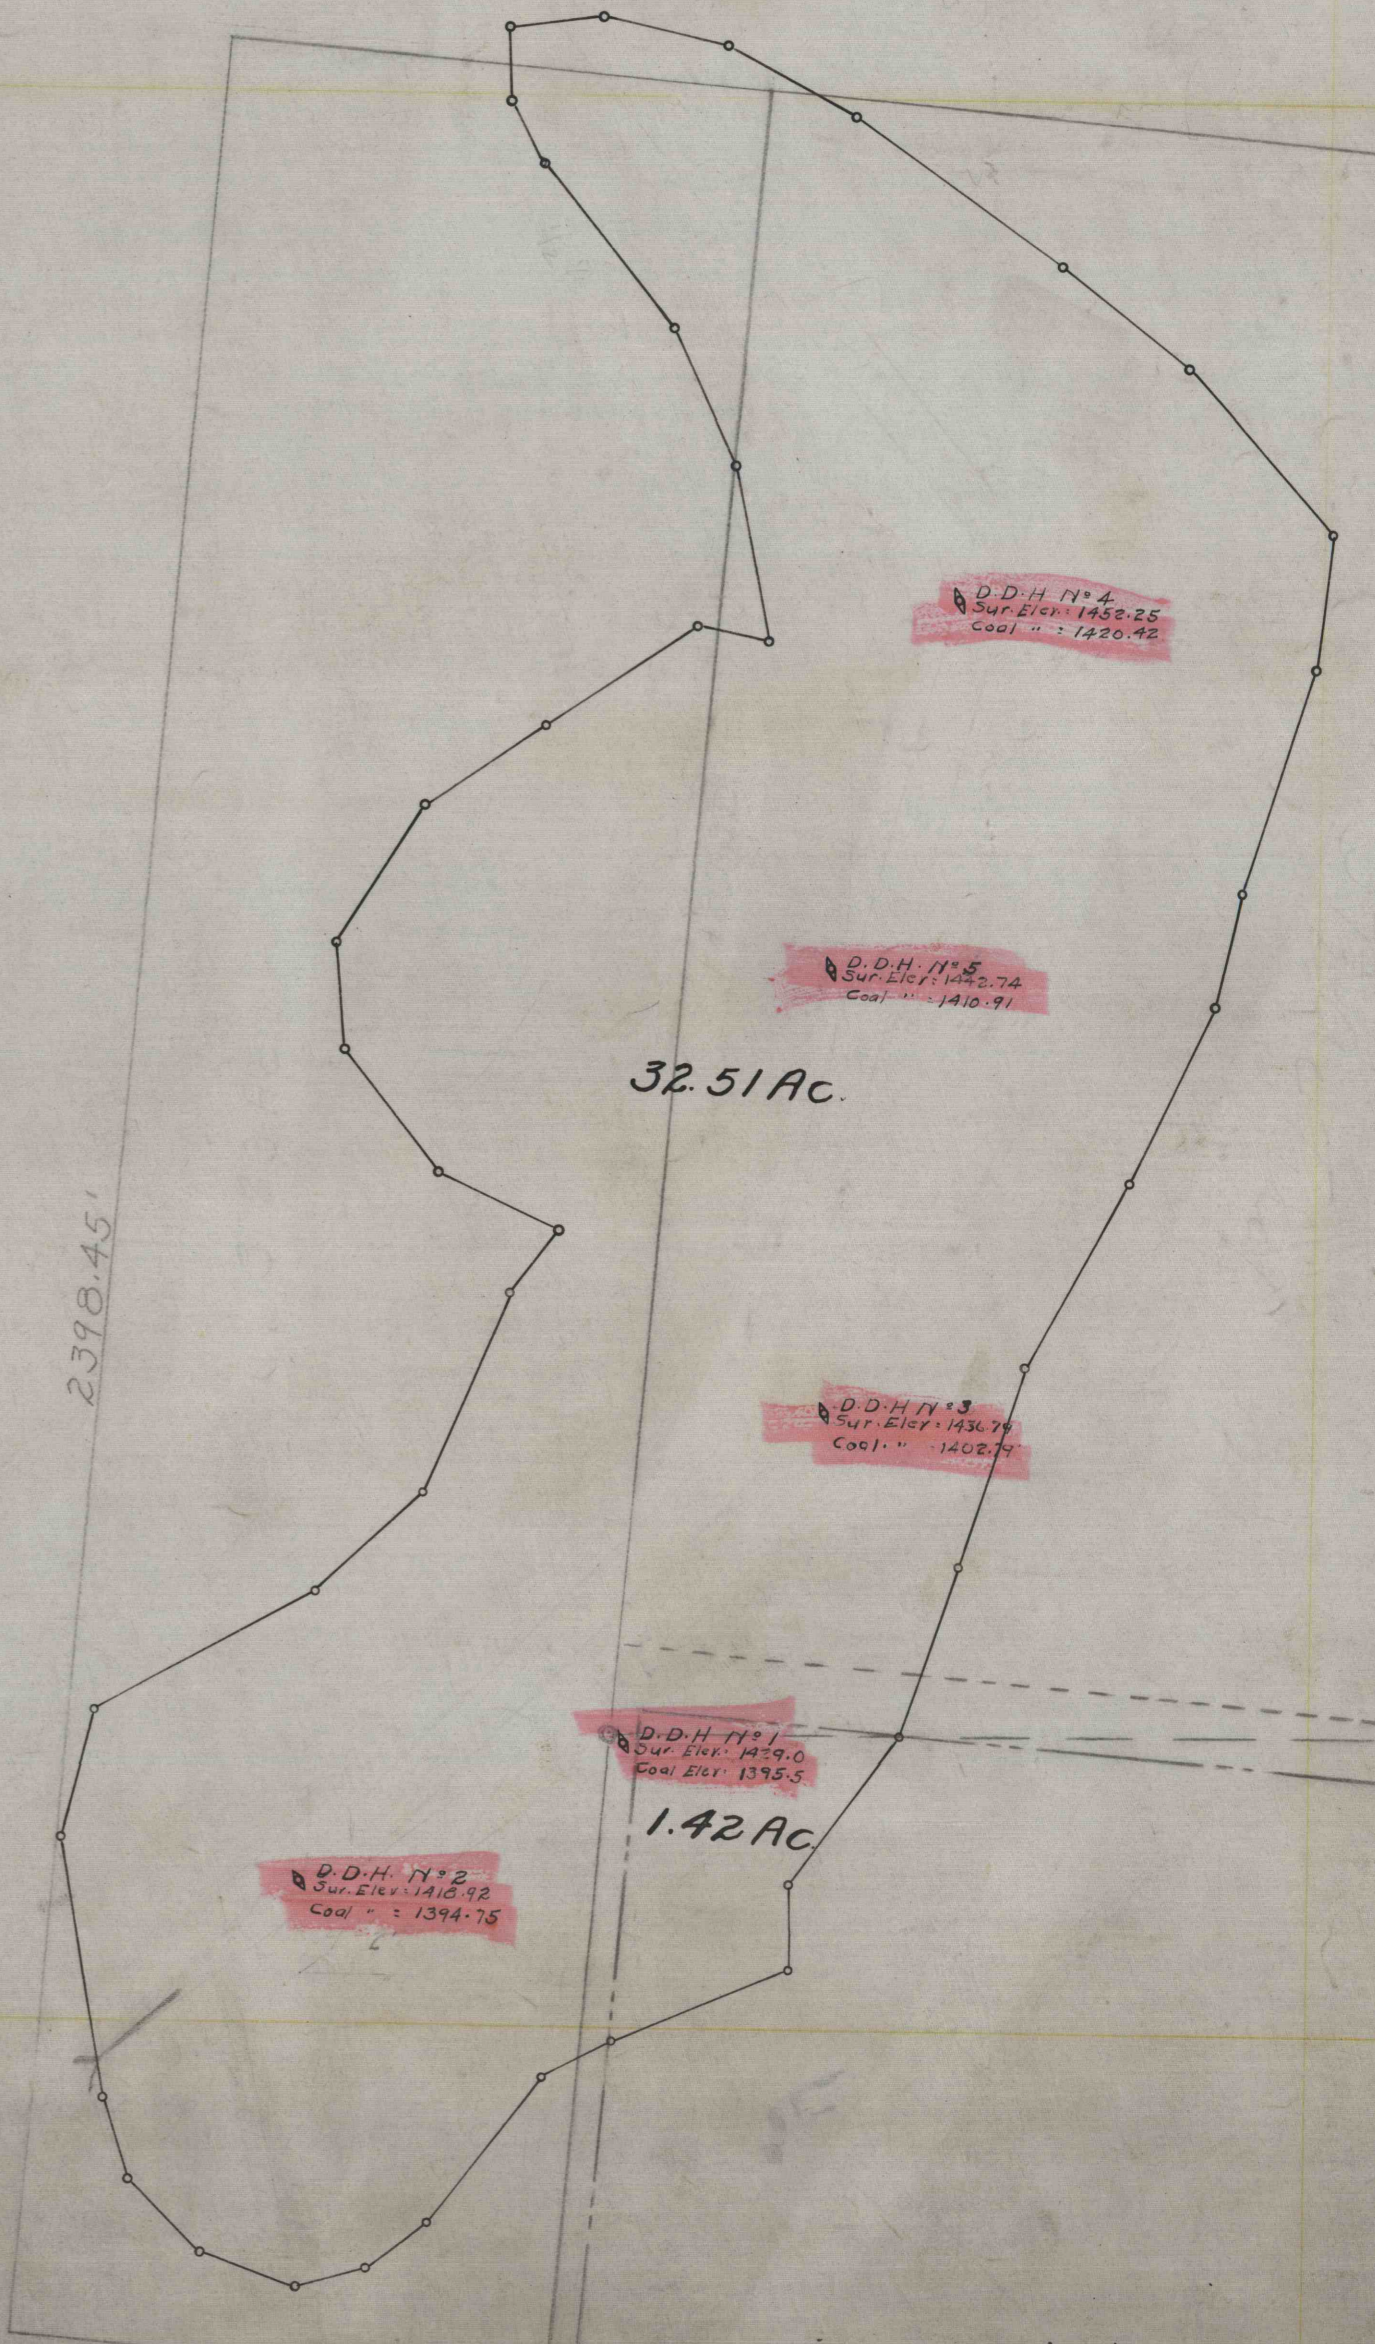

32.51 AC.

1.42 AC.

PERRY HILLS COAL CO.
Property Map.
Perry Twp, Jefferson Co., Pa.
Scale 1" = 200'.
The H. M. Kanarr Co. Engineers
Pittsburgh, Pa., Dec. 1922.

