

J. T. ATWELL

D. L. HOLT

W. R. MORRISON


D. L. HOLT

J. J. MURDY

DATE OF SURVEY  
OCTOBER 7, 10, 1943

**MINE MAP**  
**F. A. BROSKY MINE**  
 WASHINGTON TWP., JEFFERSON COUNTY, PA.  
 SCALE 1 IN. = 100 FT.      OCT., 1943

WALTER J. ZIMMERMAN  
SURVEYOR  
PUNXSUTAWNEY, PENNA.

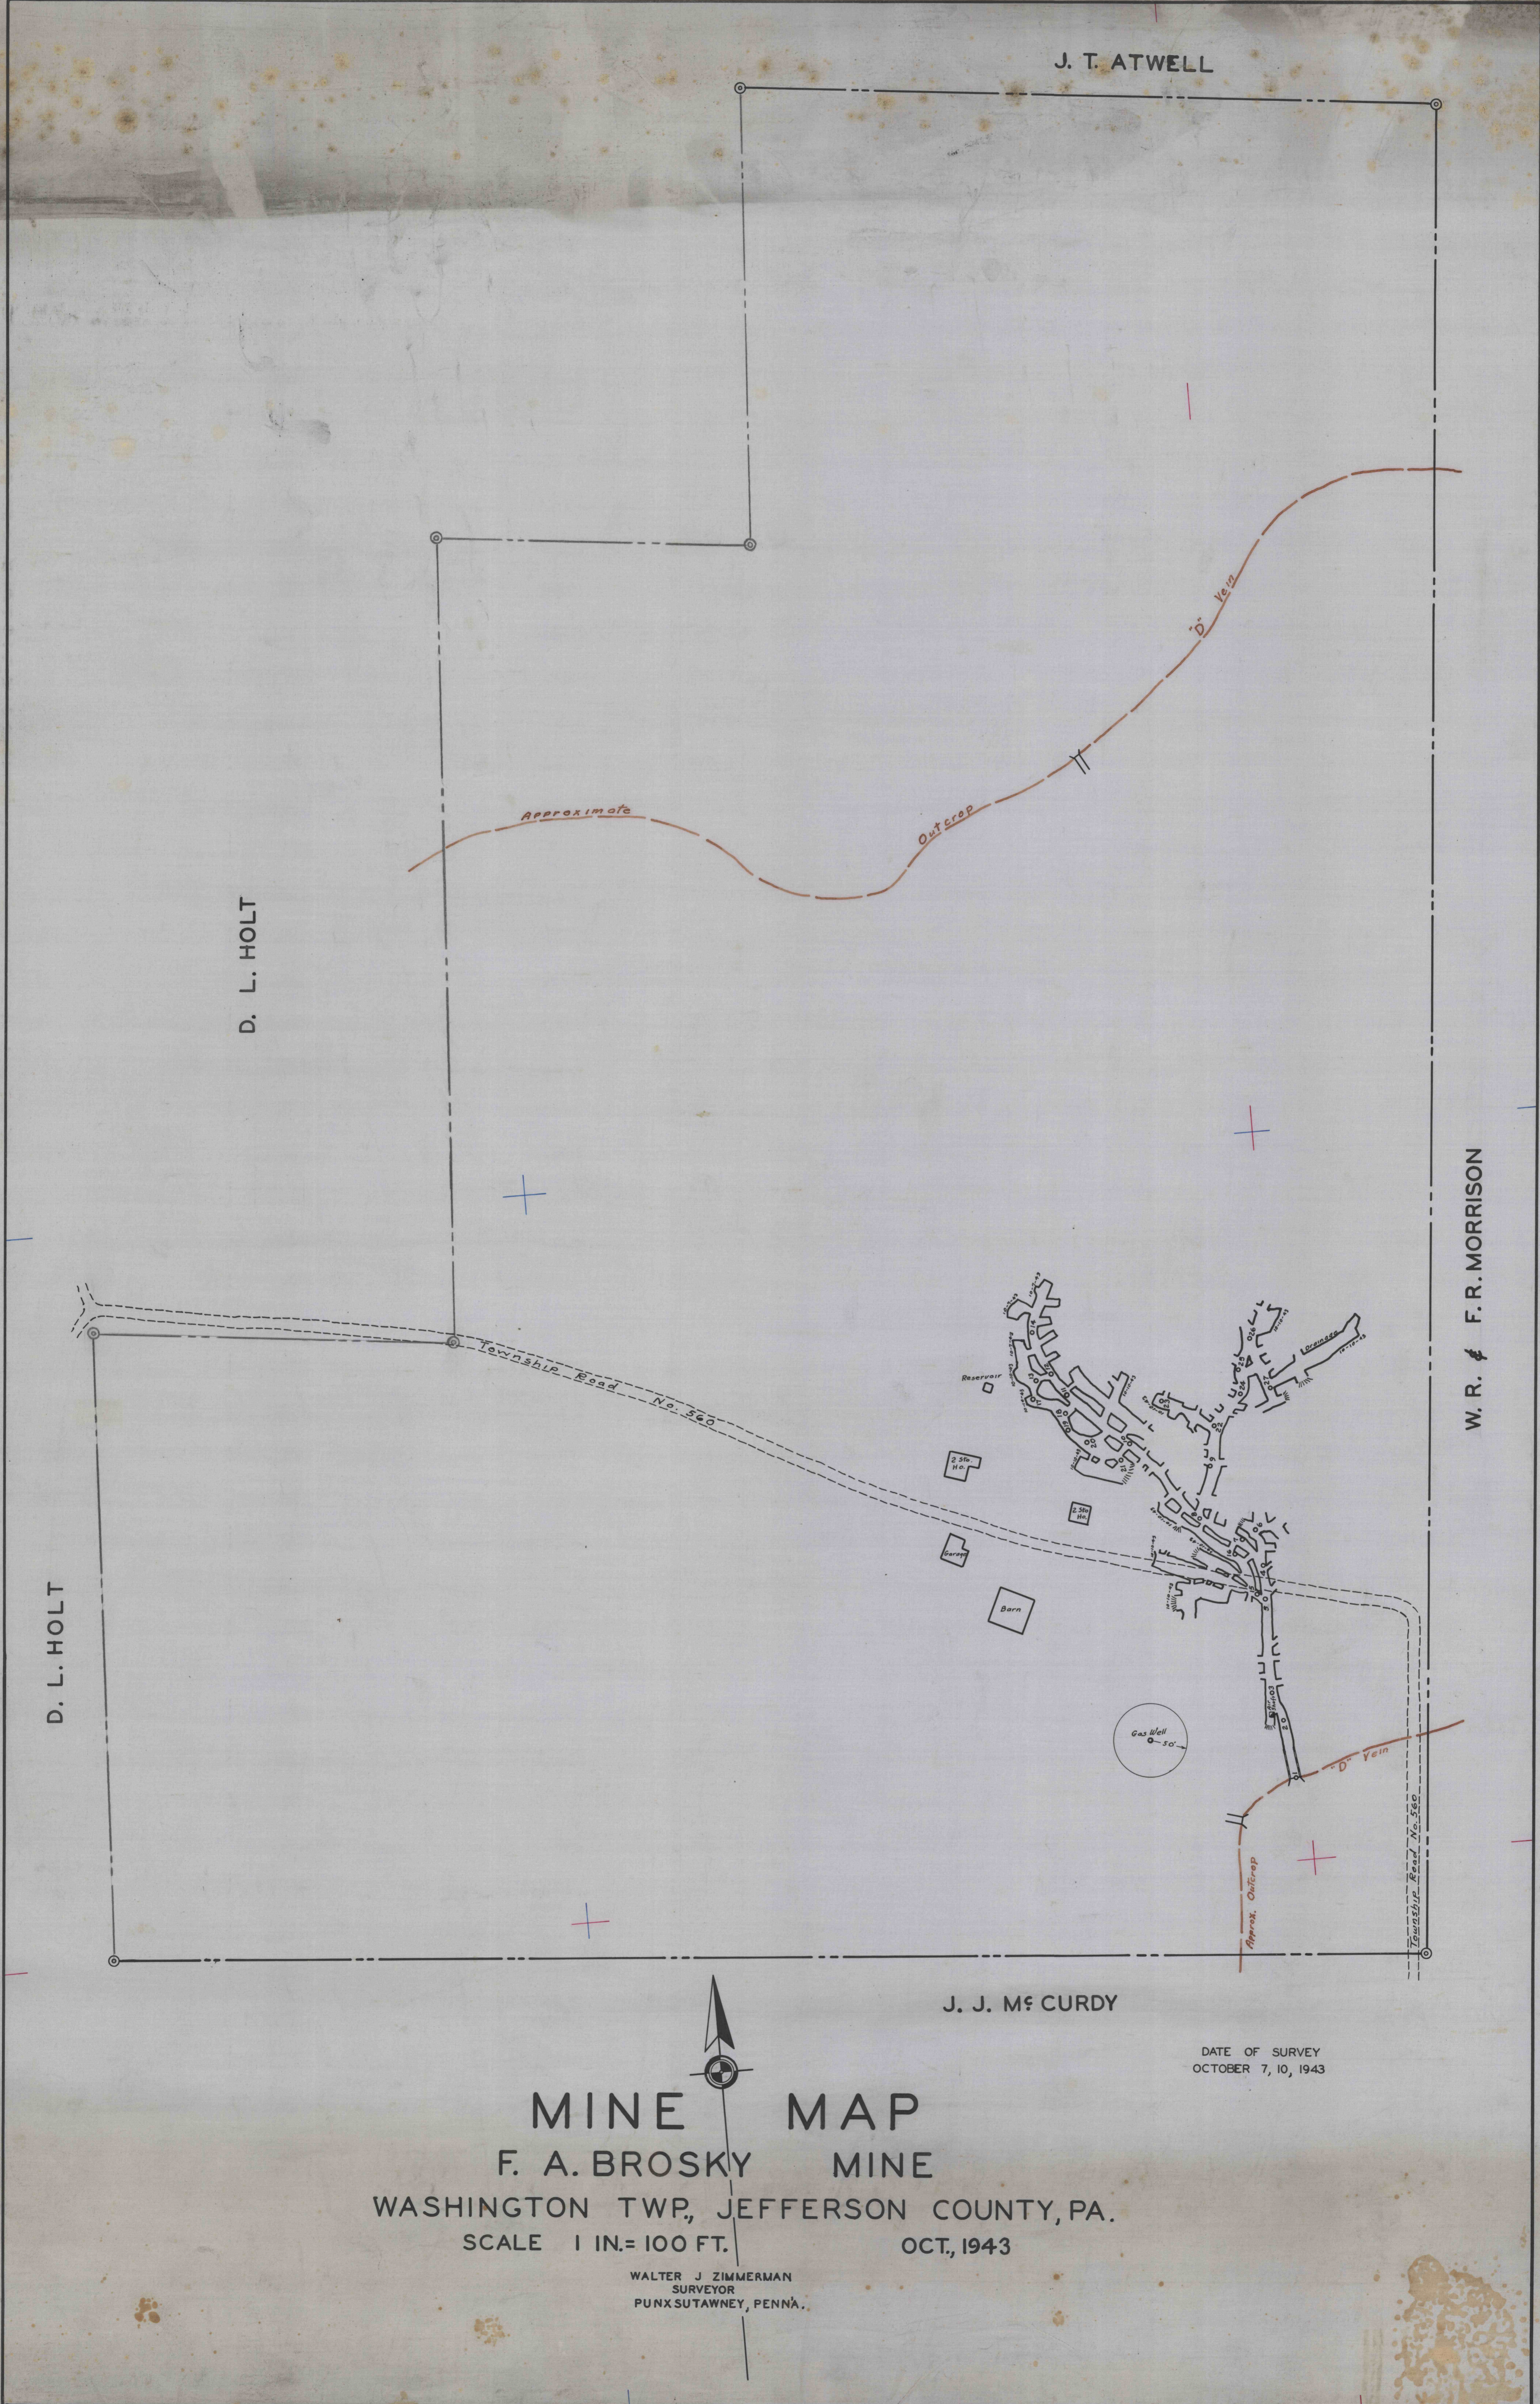

285-31  
11/15